


45

MEDICAL VILLAGE SECTION THREE  
PLAT BOOK 55, PAGE 34

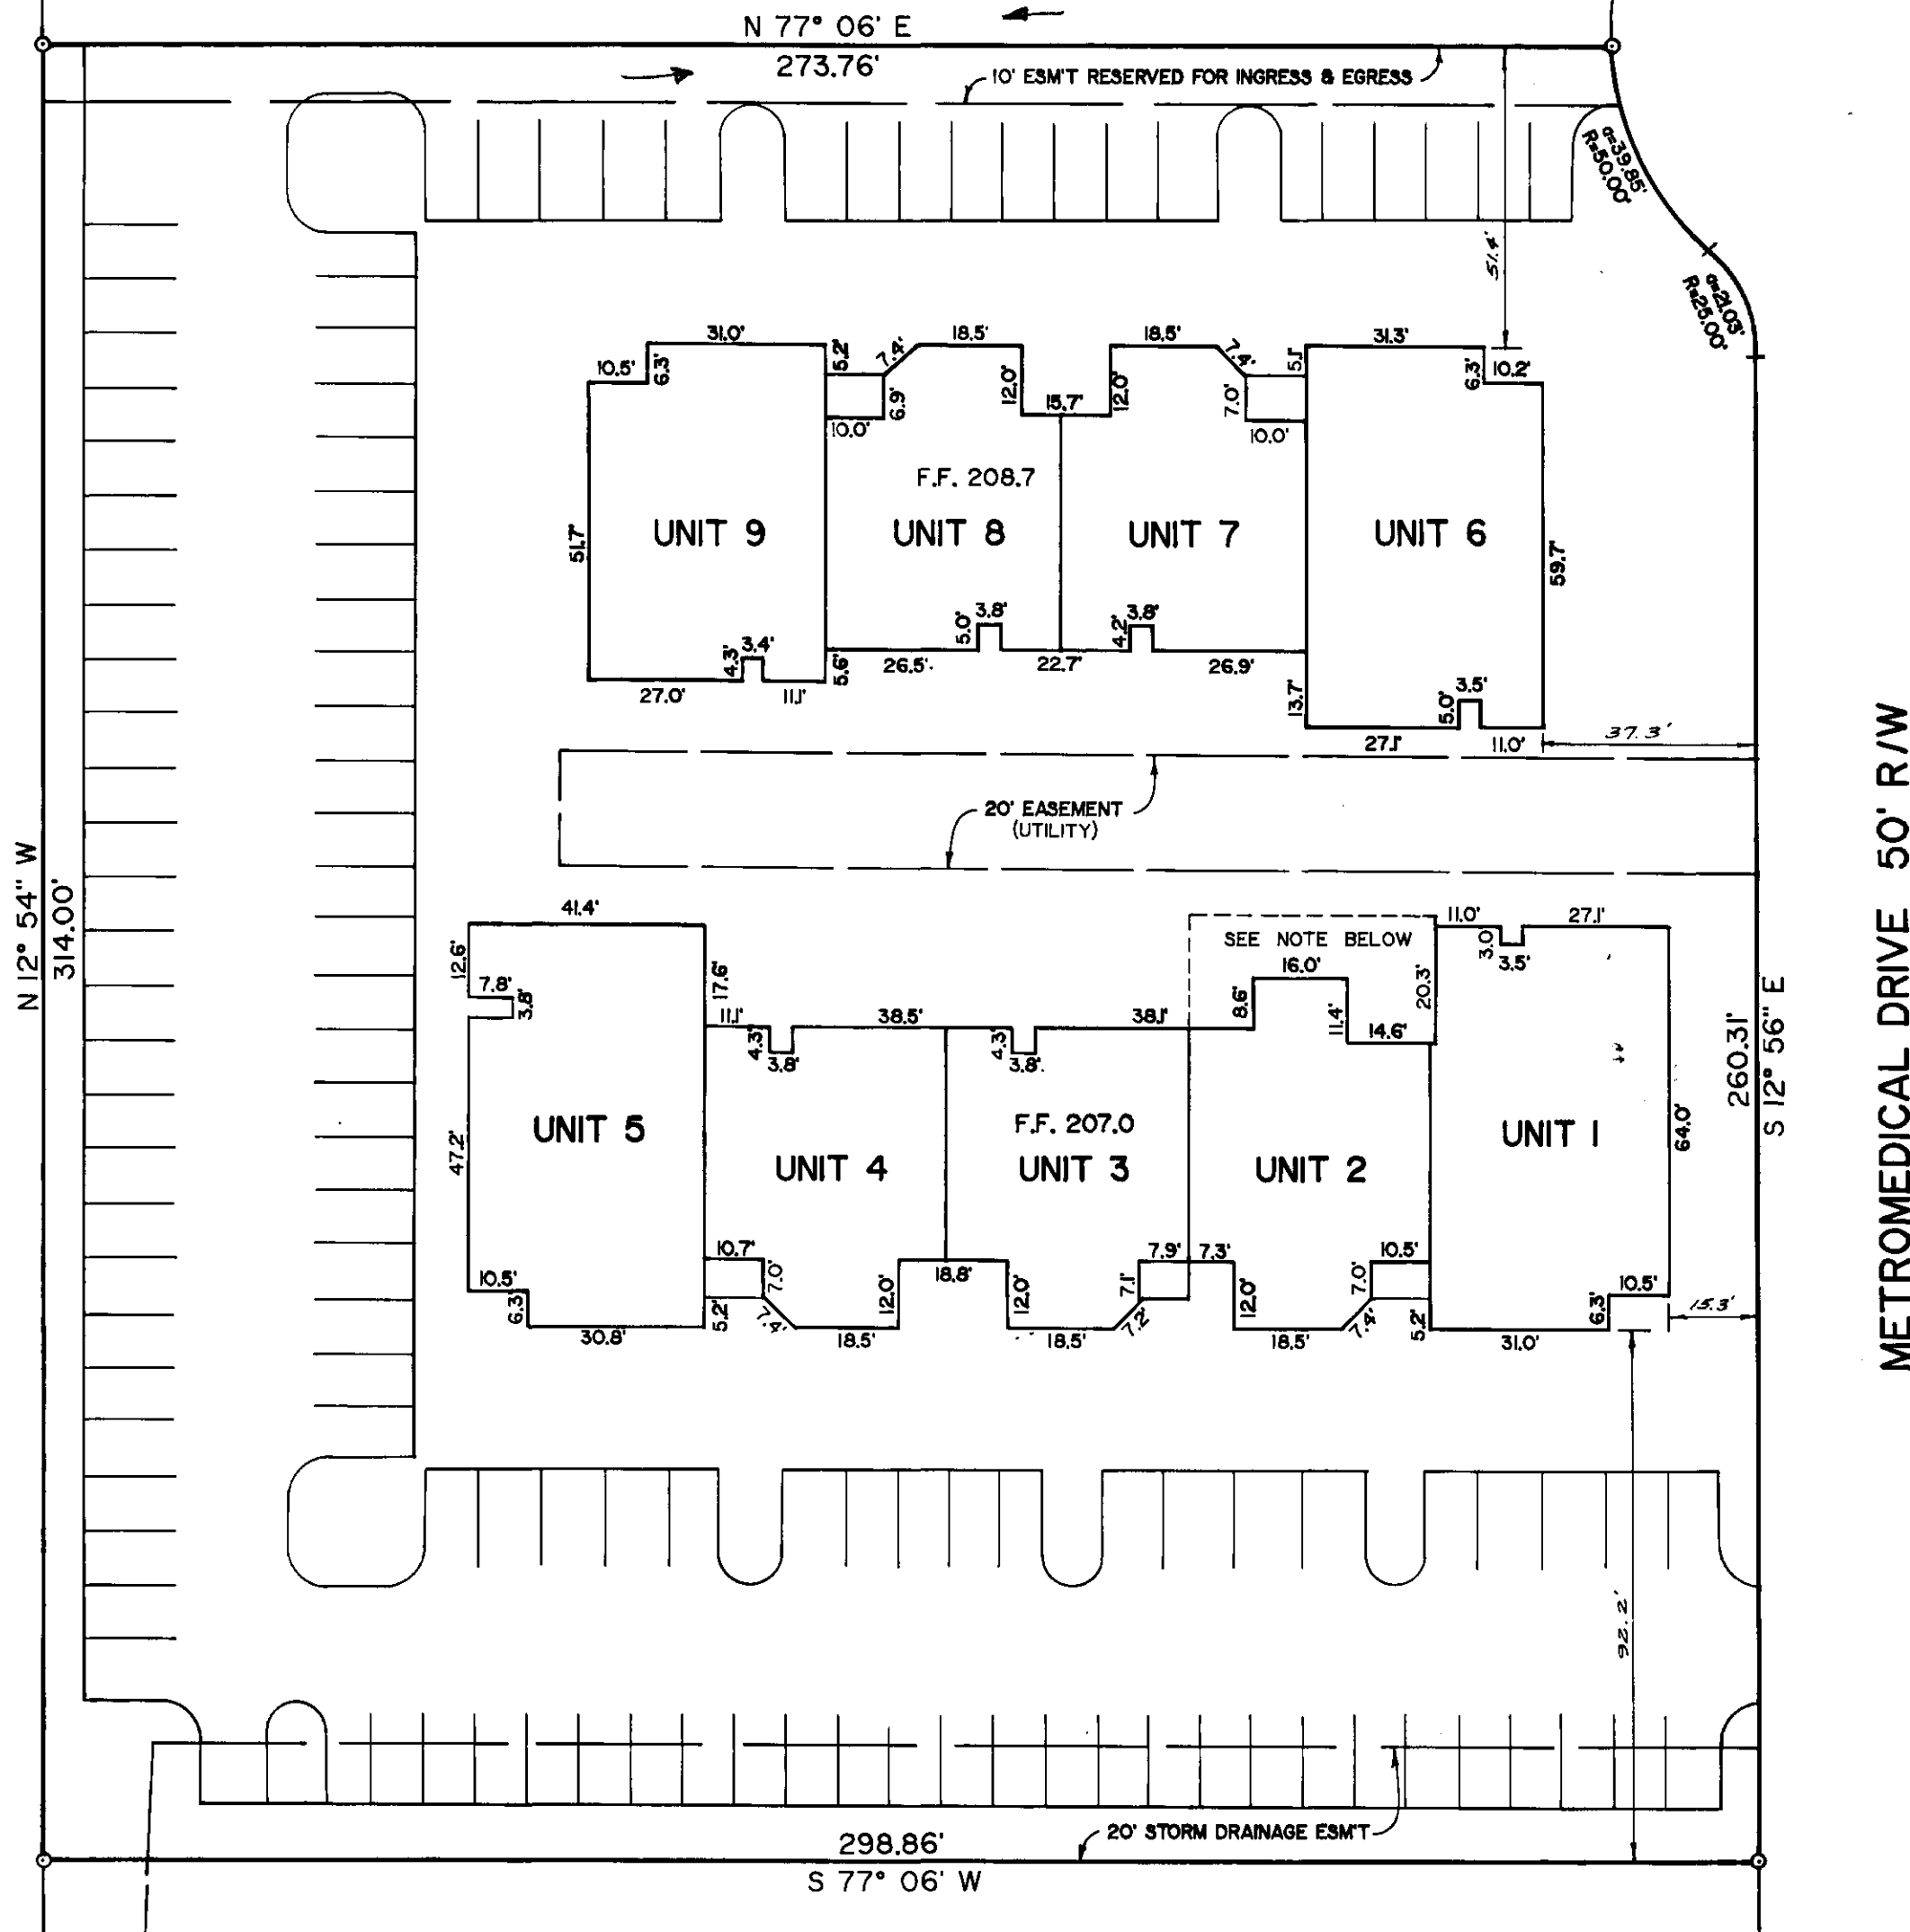

N 12° 54' W  
314.00'

METROMEDICAL DRIVE 50' R/W

VALLEYDOAH COMPANY

NOTES:

ALL THE AREA SHOWN HEREON, EXCEPTING THE NUMBERED UNITS 1,2,3,4,5,6,7,8, 8 9 AND THE STORM & UTILITY EASEMENTS, SHALL CONSTITUTE THE COMMON AREA.  
THE OWNER RESERVES THE RIGHT TO ADD AN ADDITIONAL 650 SF. OF BUILDING AREA TO UNIT #2 IN THE LOCATION SHOWN ON THIS PLAT. UNTIL OPTION IS EXERCISED, THIS AREA SHALL BE COMMON AREA.


(See Declarations recorded in Book 3224 Page 184.)

RECORDED PLAT REFERENCE: PLAT BOOK 50, PAGE 16.

40052

North Carolina, Cumberland County  
The foregoing or annexed certificate of Margaret L. Goodwin  
Notary Public/Notaries Public is/are certified to be correct.  
This instrument was presented for registration and recorded in this Office at Book 2, Page 45-52  
This 12 day of November, 1986 at 9:35 o'clock A.M.  
GEORGE E. TATUM By Jessamine L. Wilburn  
Register of Deeds Deputy Register of Deeds

State of North Carolina CUMBERLAND County  
I, JAMES M. KIZER certify that this map was drawn from an actual survey made by me (and description recorded in Book 3224, Page 184) that the error of closure as calculated by latitudes and departures is 1.5200; that the boundaries not surveyed are shown as broken lines plotted from information found in Book 3224, Page 184; that this map was prepared in accordance with G.S. 47-30, as amended. Witness my hand (and stamp or seal) this 27 day of AUGUST, A.D. 1986.  
Seal or Stamp  
Registration Number L-2243  
State of North Carolina CUMBERLAND County  
I, a Notary Public of the County and State aforesaid, certify that JAMES M. KIZER, a registered land surveyor, personally appeared before me this day and acknowledged the execution of the foregoing instrument. Witness my hand and official stamp or seal, this 27 day of AUGUST, A.D. 1986.  
Seal or Stamp  
My commission expires March 20, 1990

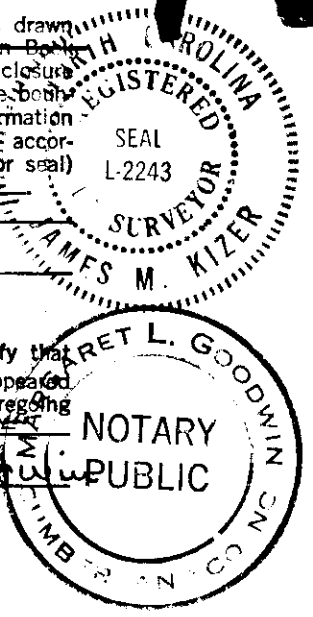


Know all men by these presents, that (I) hereby acknowledge this plat and allotment to be (M.Y.) free act and deed and that (I) do hereby dedicate to public use as (EASEMENTS) all areas so shown or indicated on said plat.  
Margaret L. Goodwin  
Notary Public

CERTIFICATION BY PROFESSIONAL ENGINEER

I, JAMES M. KIZER, Professional Engineer of North Carolina, No. 4783, certify that the attached plat map entitled "Medco Condominiums" and seven (7) pages of plans and drawings fully and accurately depict the layout, unit numbers, location, floor elevations, (see architectural plans for varying ceiling heights) and dimensions of the condominium units as built, of Medco Condominiums, and that said attached plans and drawings are accurate copies of portions of the plans as filed with and approved by the Cumberland County Joint Planning Board.

James M. Kizer  
JAMES M. KIZER, P.E. 4783

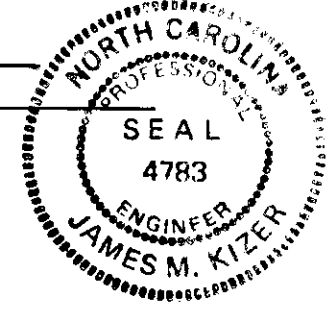

MEDCO CONDOMINIUMS  
PROPERTY OF  
MEDCO INVESTORS  
FAYETTEVILLE, NORTH CAROLINA.  
SCALE: 1" = 30'  
AUGUST 1986

MOORMAN & KIZER, INC.  
FAYETTEVILLE, N. C.




Condo 2. 45

46

46


MEDCO CONDOMINIUMS  
J.J. ROSE, ARCHITECT  
1981

NOTE: GENERATOR & RADIOGRAPHIC TABLE IN ROOM 204 & PROCESSOR & CONTROL UNIT IN ROOM 205 ARE THE PROPERTY OF X-RAY EQUIPMENT. EQUIPMENT WILL BE OPERATED & INSTALLED BY OWNER. CONTRACTOR TO PROVIDE ELECTRICAL, PLUMBING & MECHANICAL WORK IN ALL ROOMS. CONTRACTOR TO PROVIDE WATER INSTALLATION. EQUIPMENT INSTALLER TO PROVIDE ALL OF THESE ITEMS. TEL. 827-5007

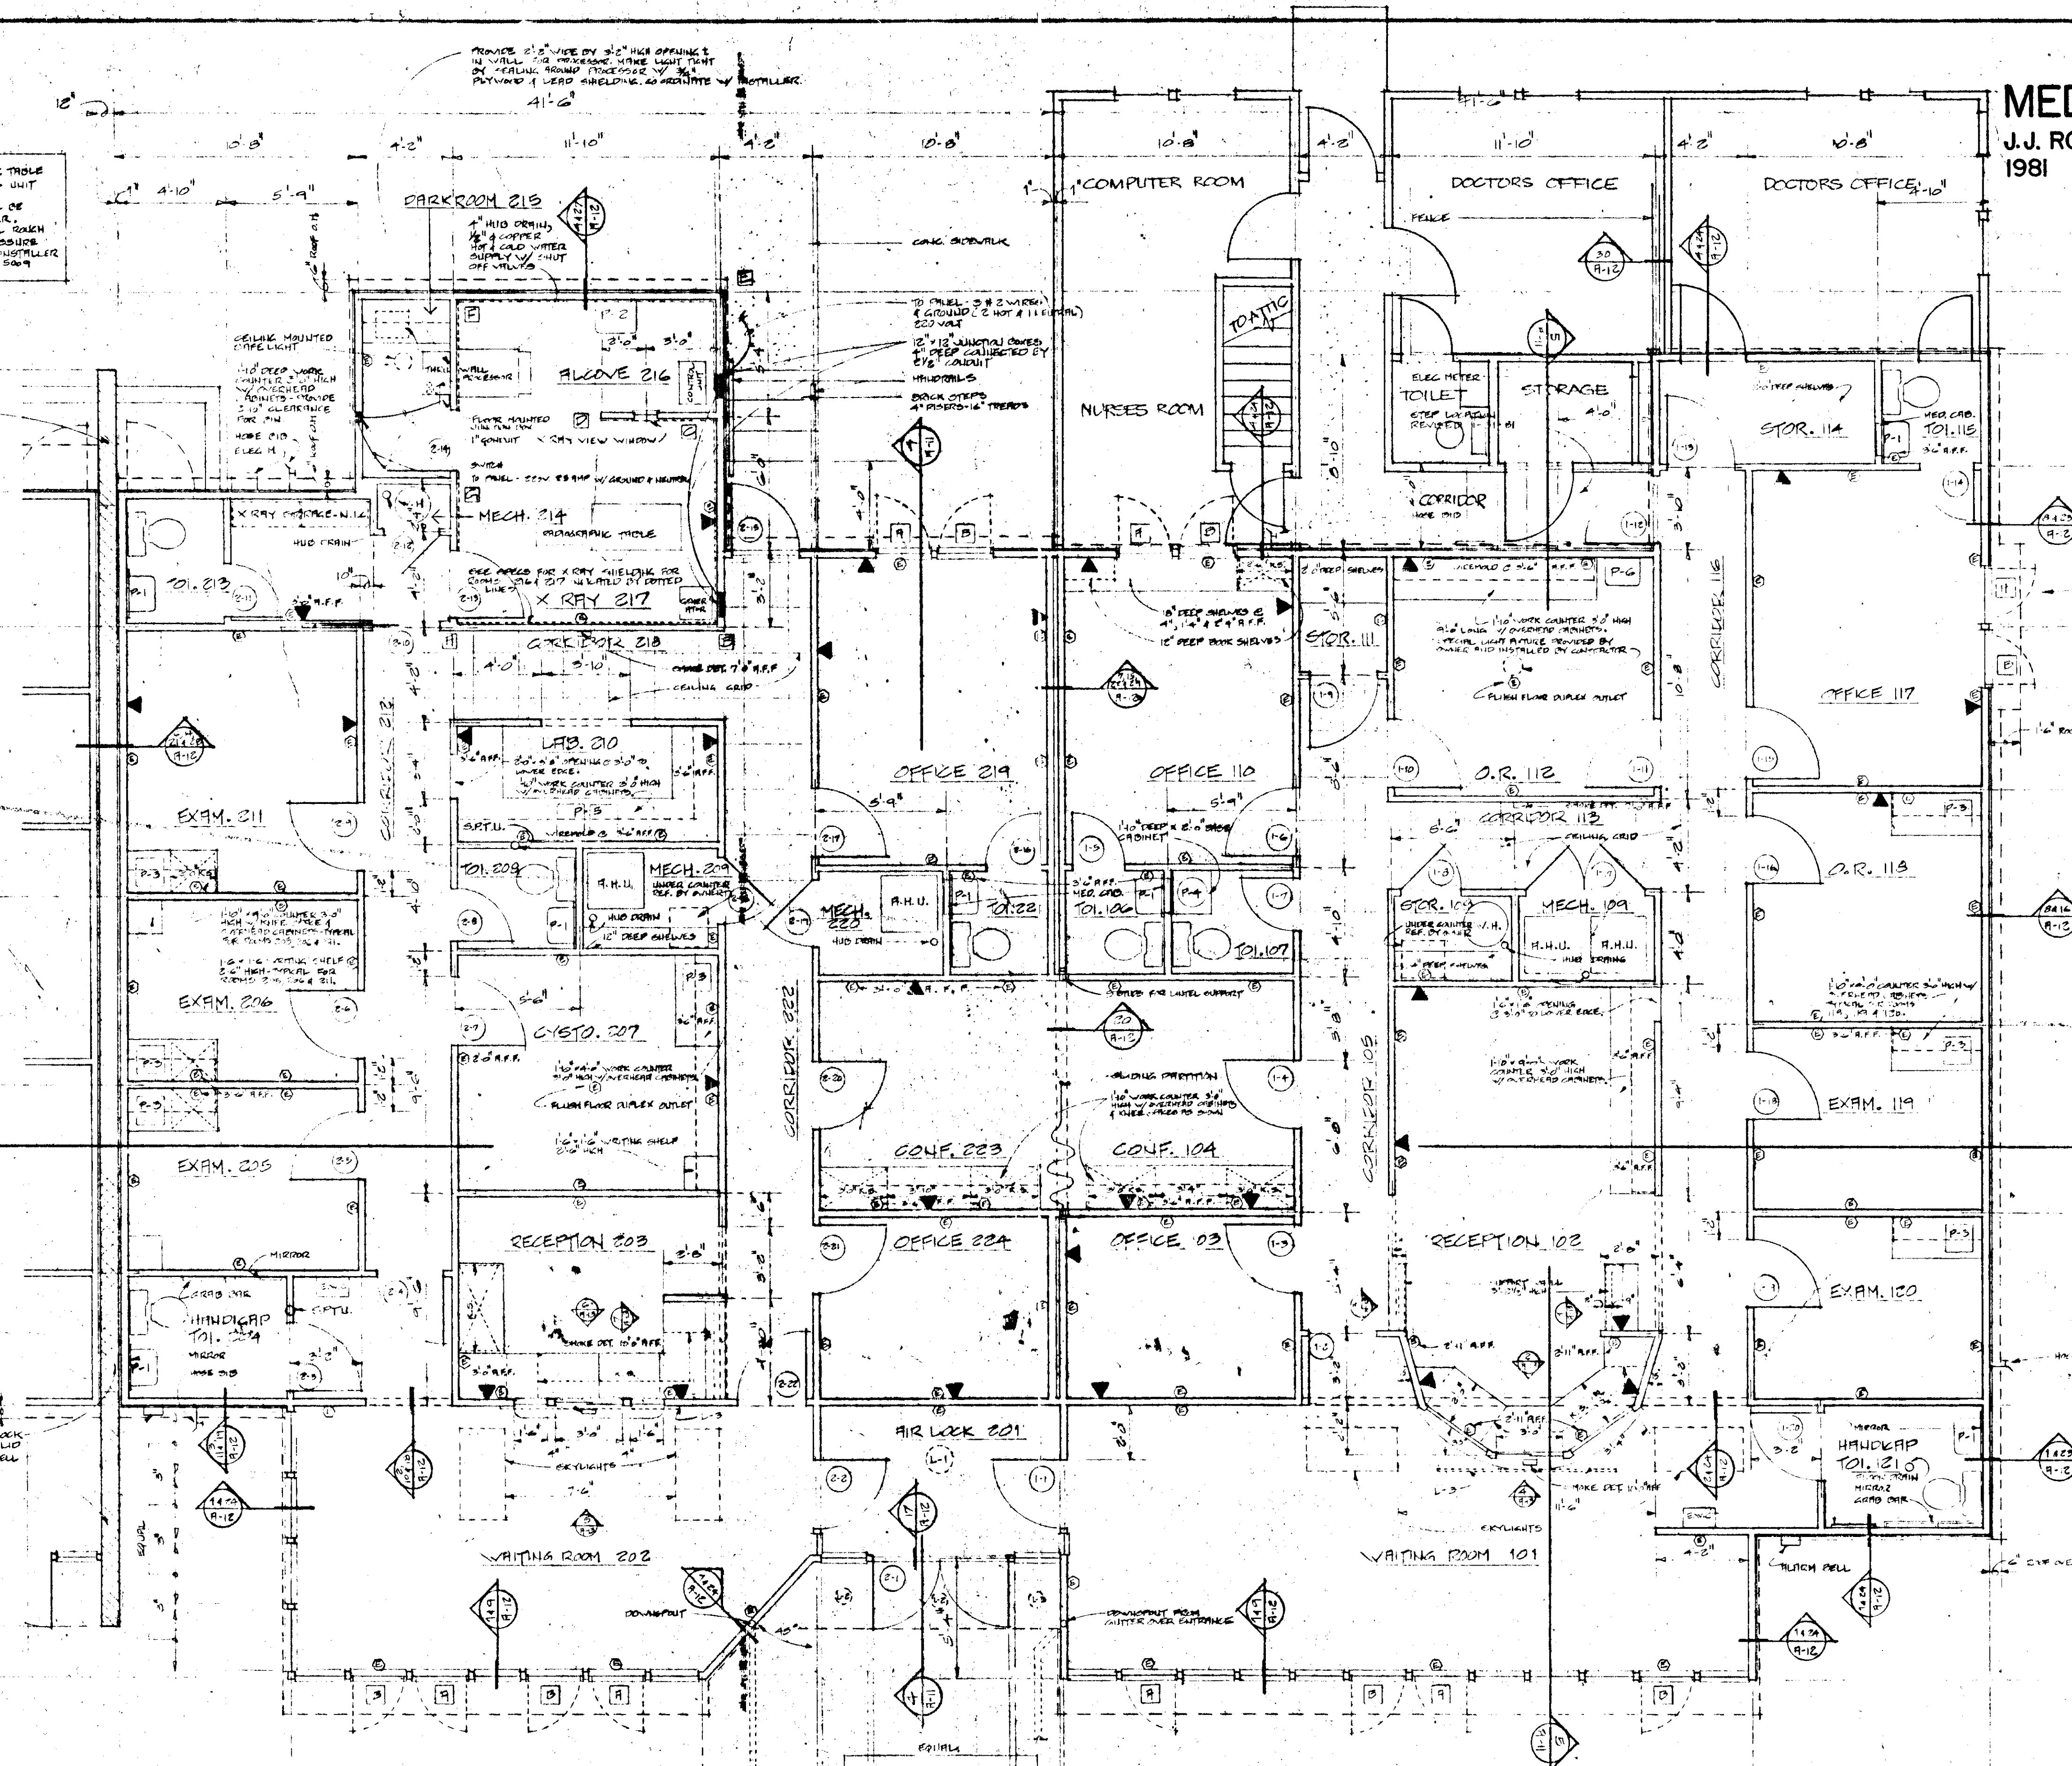

FLOOR PLAN-UNIT 2  
SCALE: 1/4" = 1'-0"  
15 PHONE LOCATIONS - THIS UNIT


FLOOR PLAN-UNITS 1 & 2  
SCALE: 1/4" = 1'-0"  
15 PHONE LOCATIONS - THIS UNIT

<b>MEDICAL VILLAGE</b>		MEDICAL VILLAGE DRIVE		FAYETTEVILLE, NORTH CAROLINA		FLOOR PLAN-UNITS 1 & 2		DRAWN BY: J.A.C. CHECKED BY: R.A.W. APPROVED BY: J.A.C.	 3414 FAYETTEVILLE, N.C.	<b>A4</b> OF 14
<b>JAMES A. CLAYWELL, ARCHITECT</b>		1012 WESTMONT DRIVE		FAYETTEVILLE, NORTH CAROLINA 28305		919-485-3780		DATE: DEC. 31, 1980 REV. FEB. 6 & 7, 1981 JOB NO. 8001		

Condo 2-46



47

47

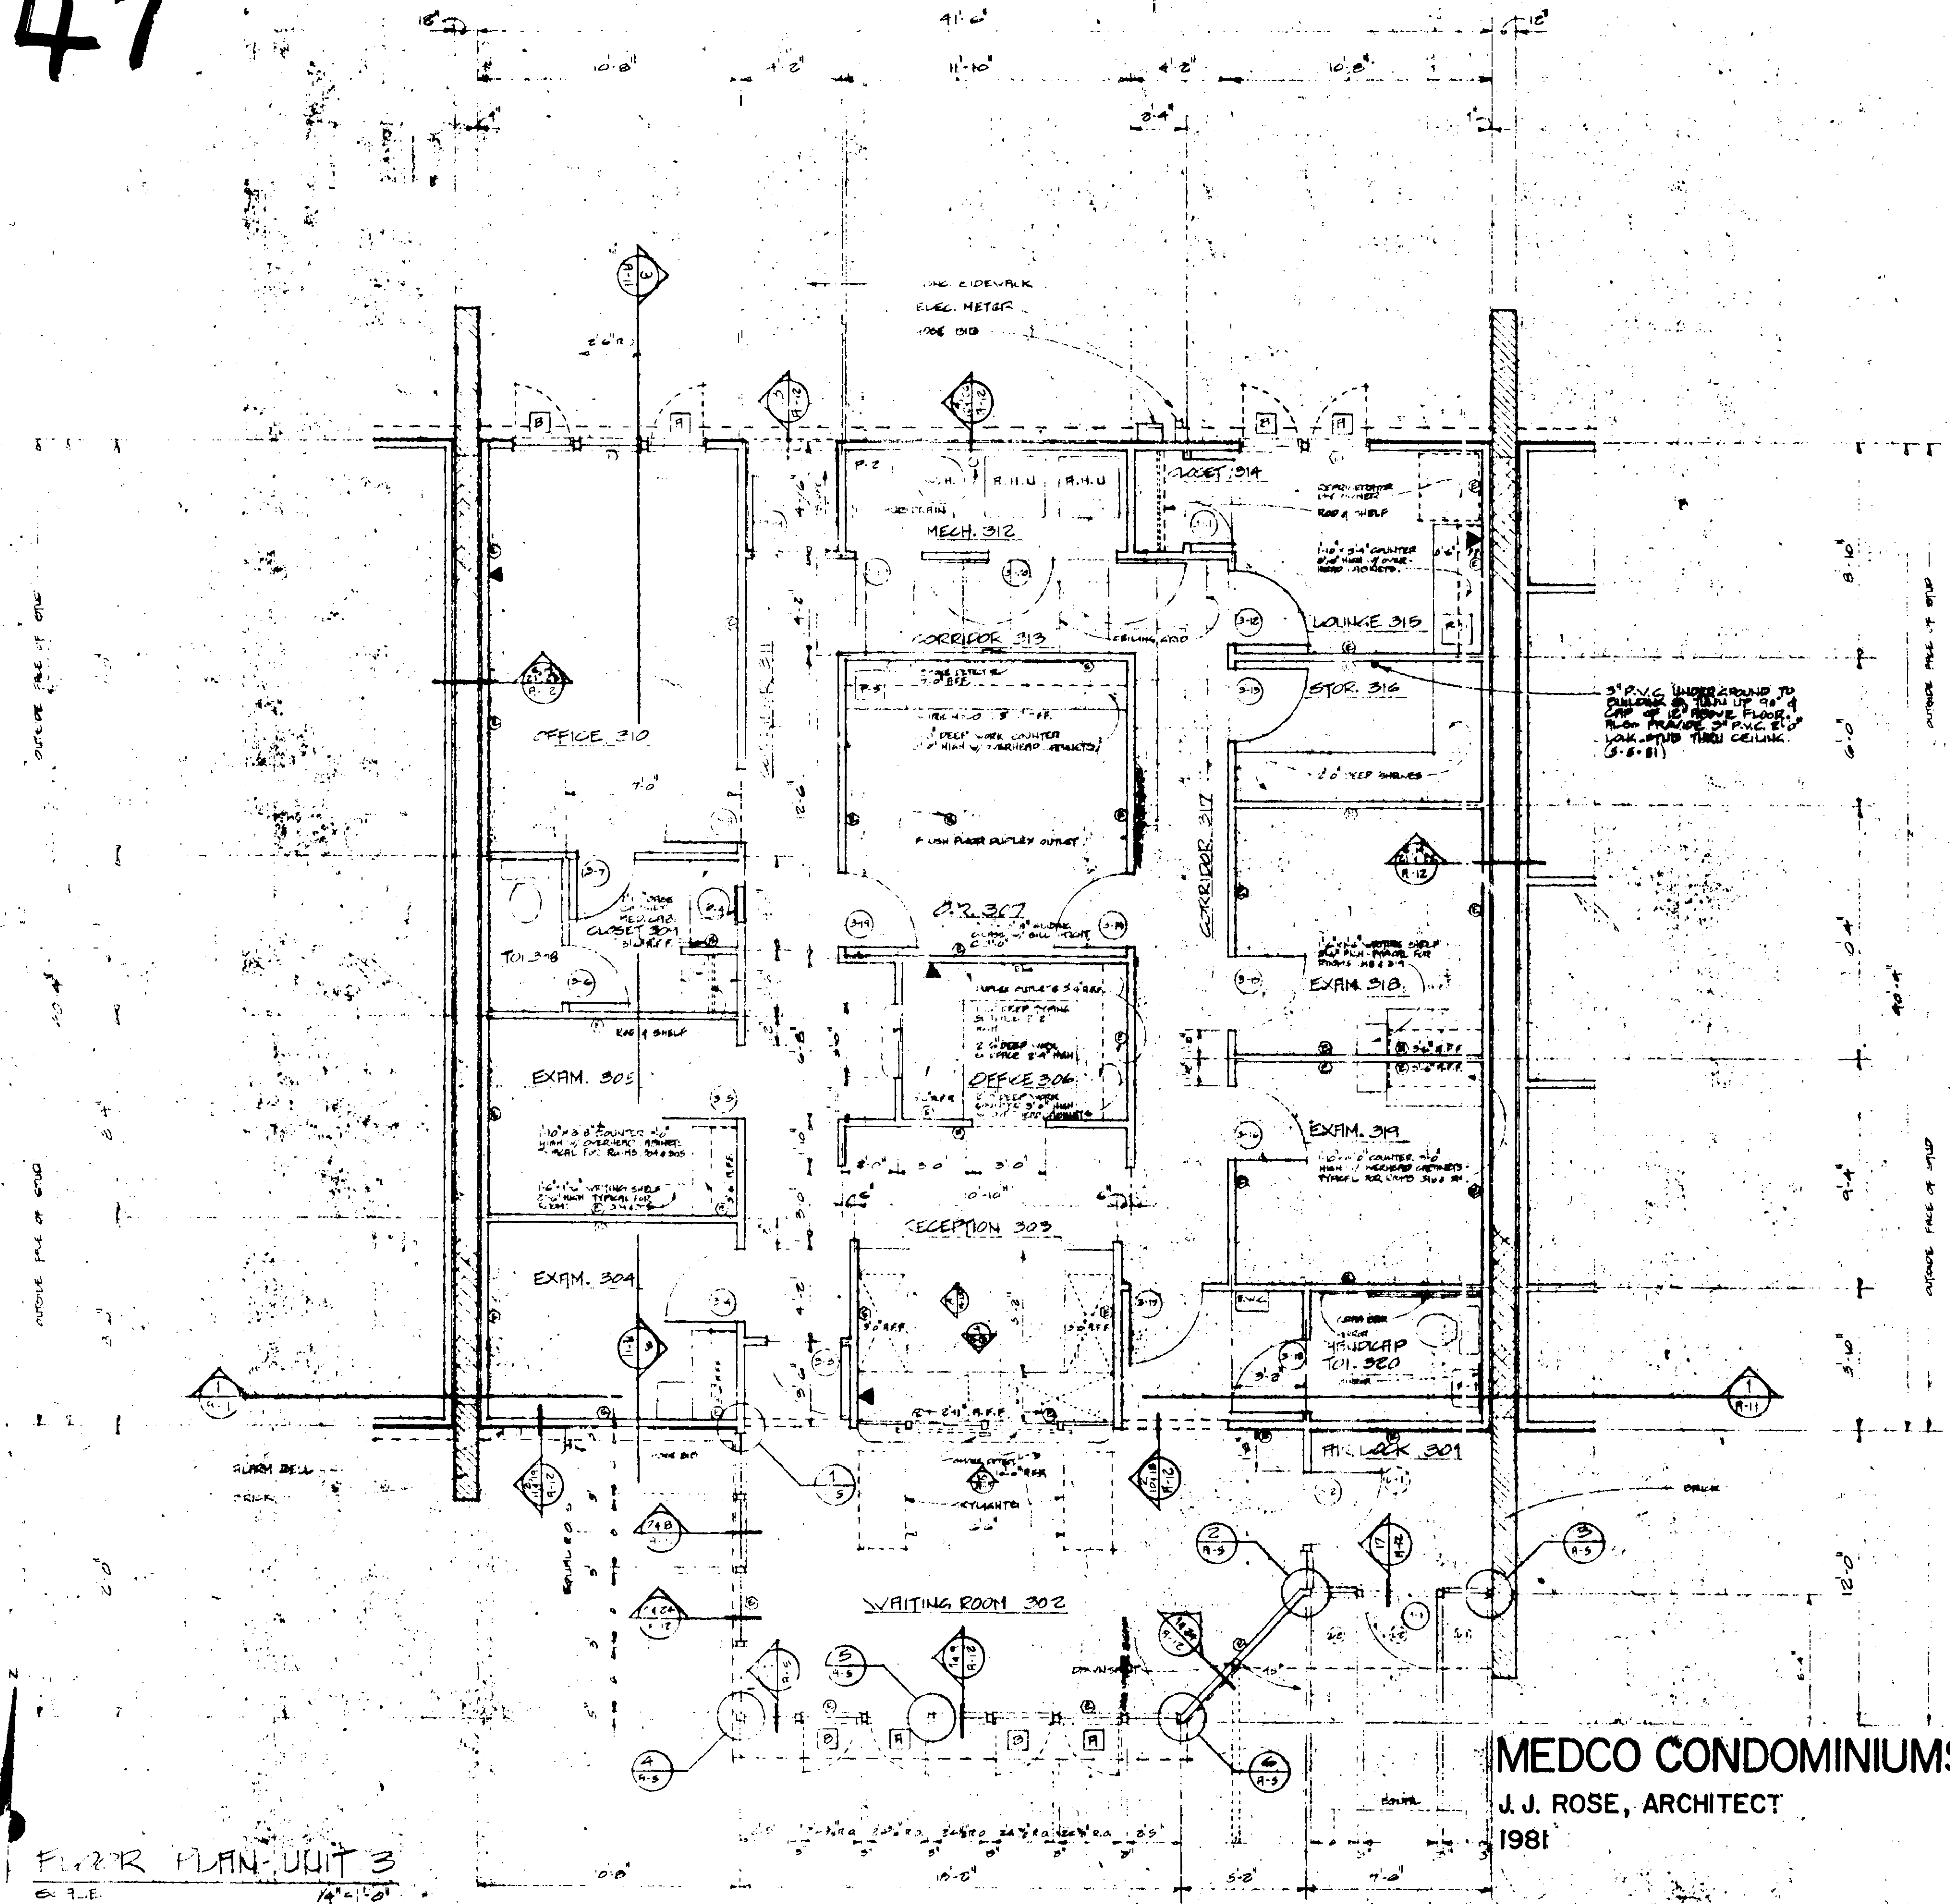

FLOOR PLAN - UNIT 3  
 F.F.E.  
 + PHONE LOCATIONS - THIS UNIT.

**MEDCO CONDOMINIUMS**  
 J. J. ROSE, ARCHITECT  
 1981

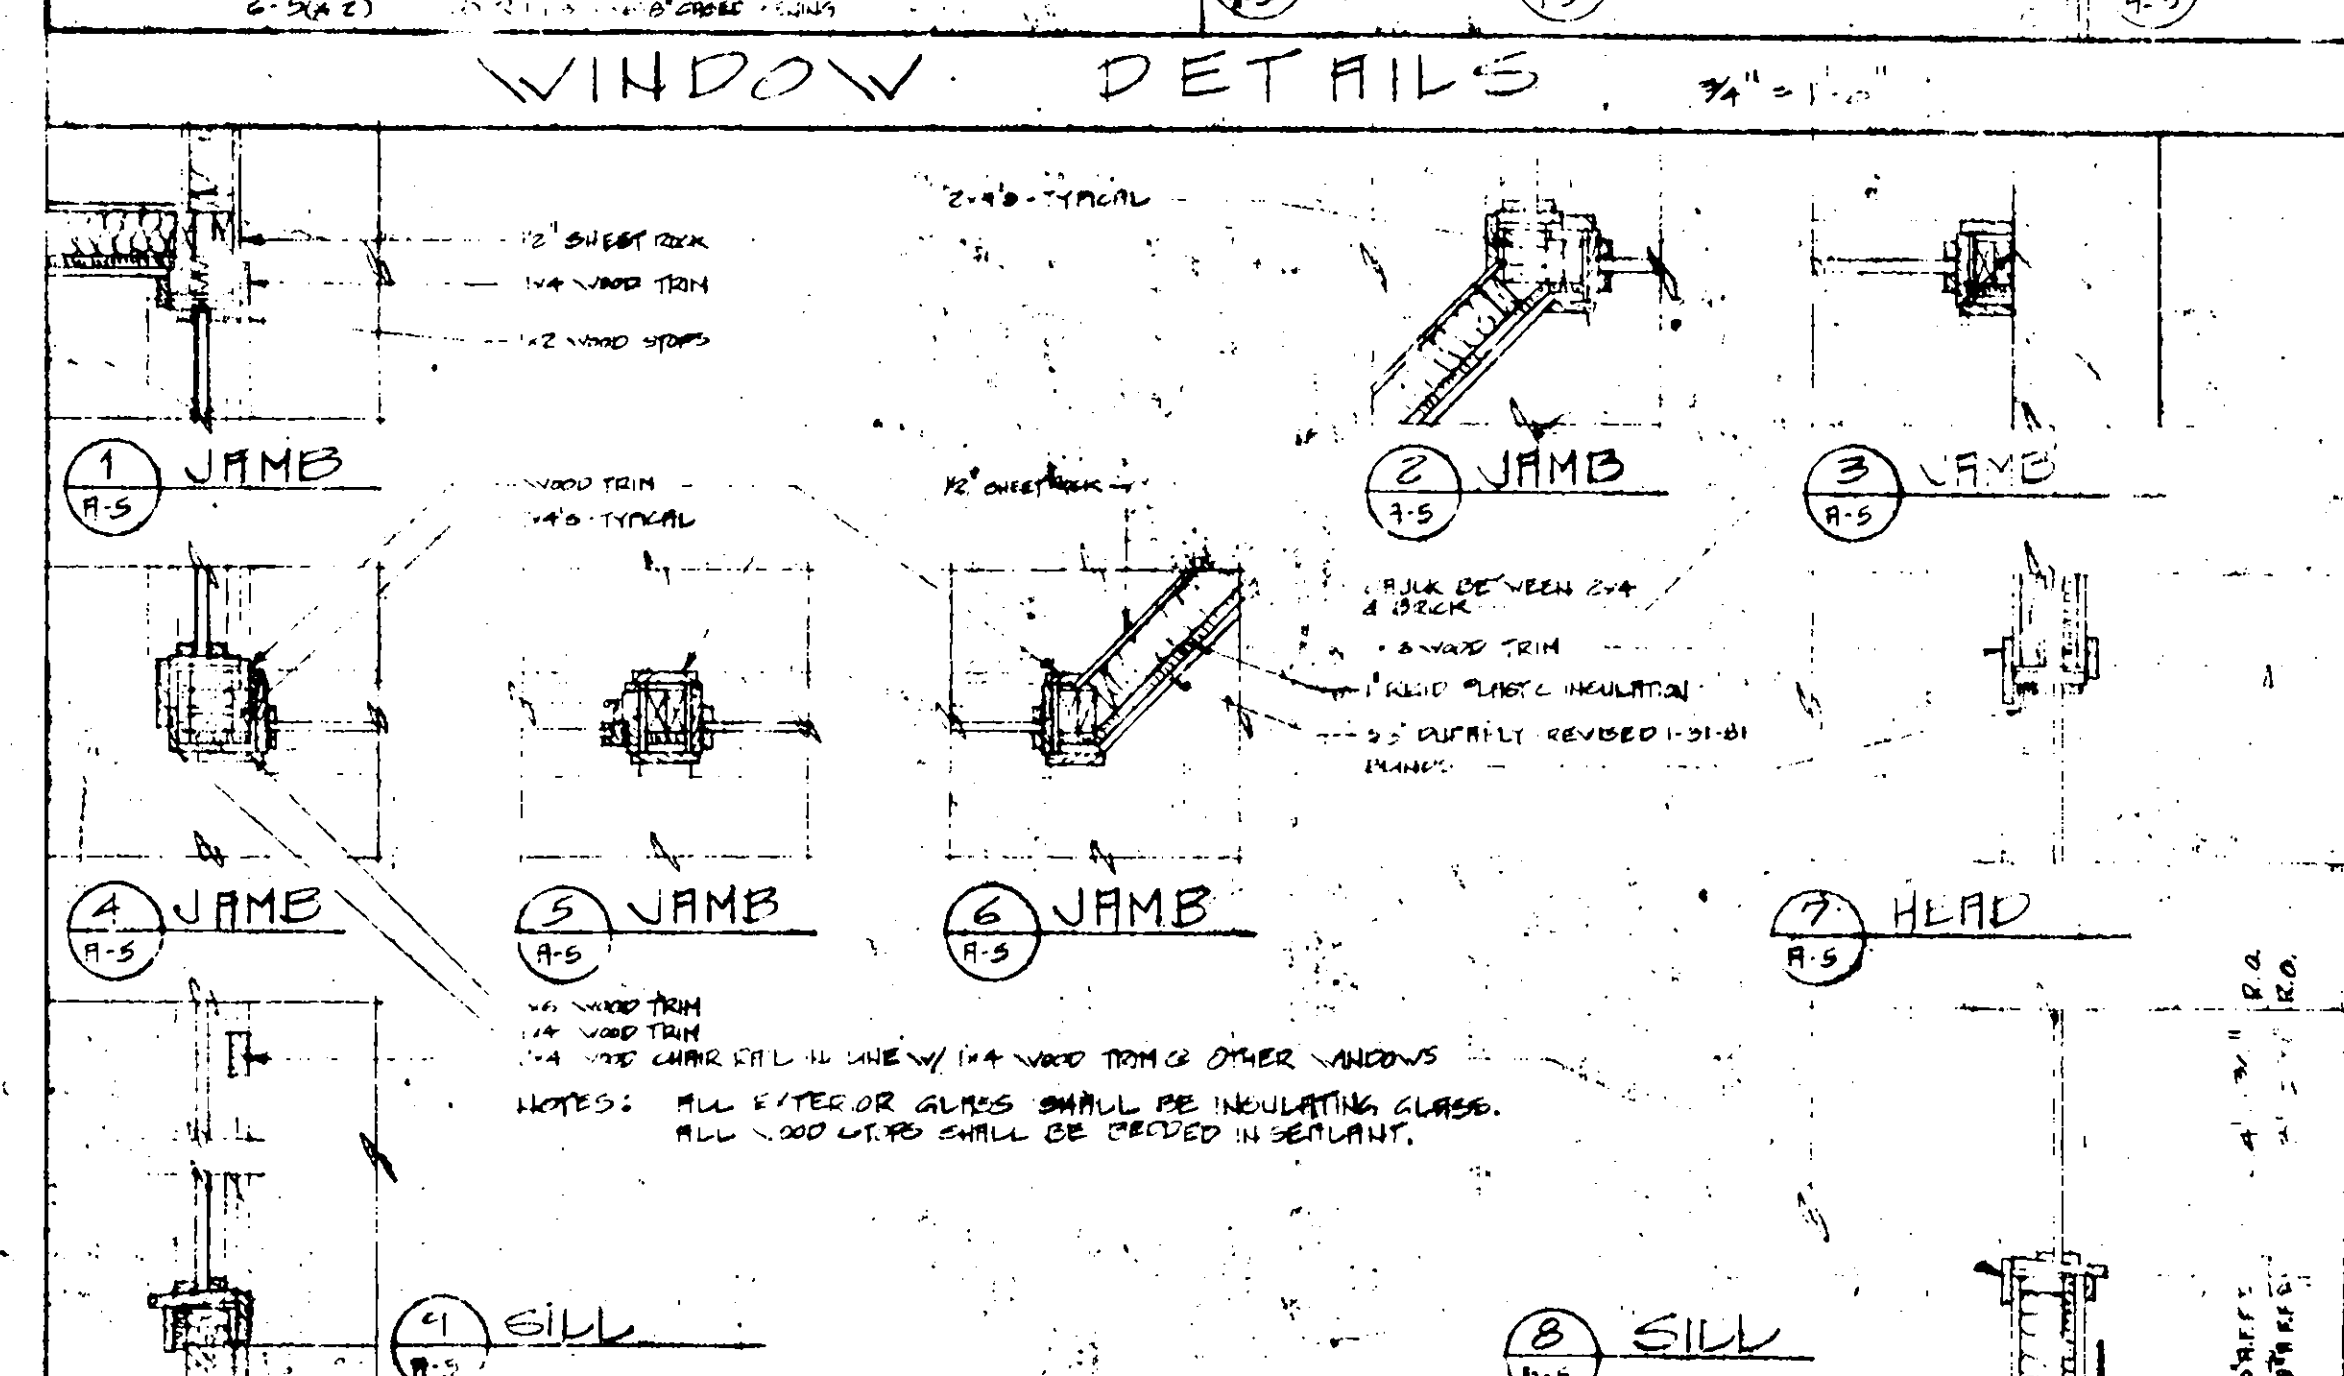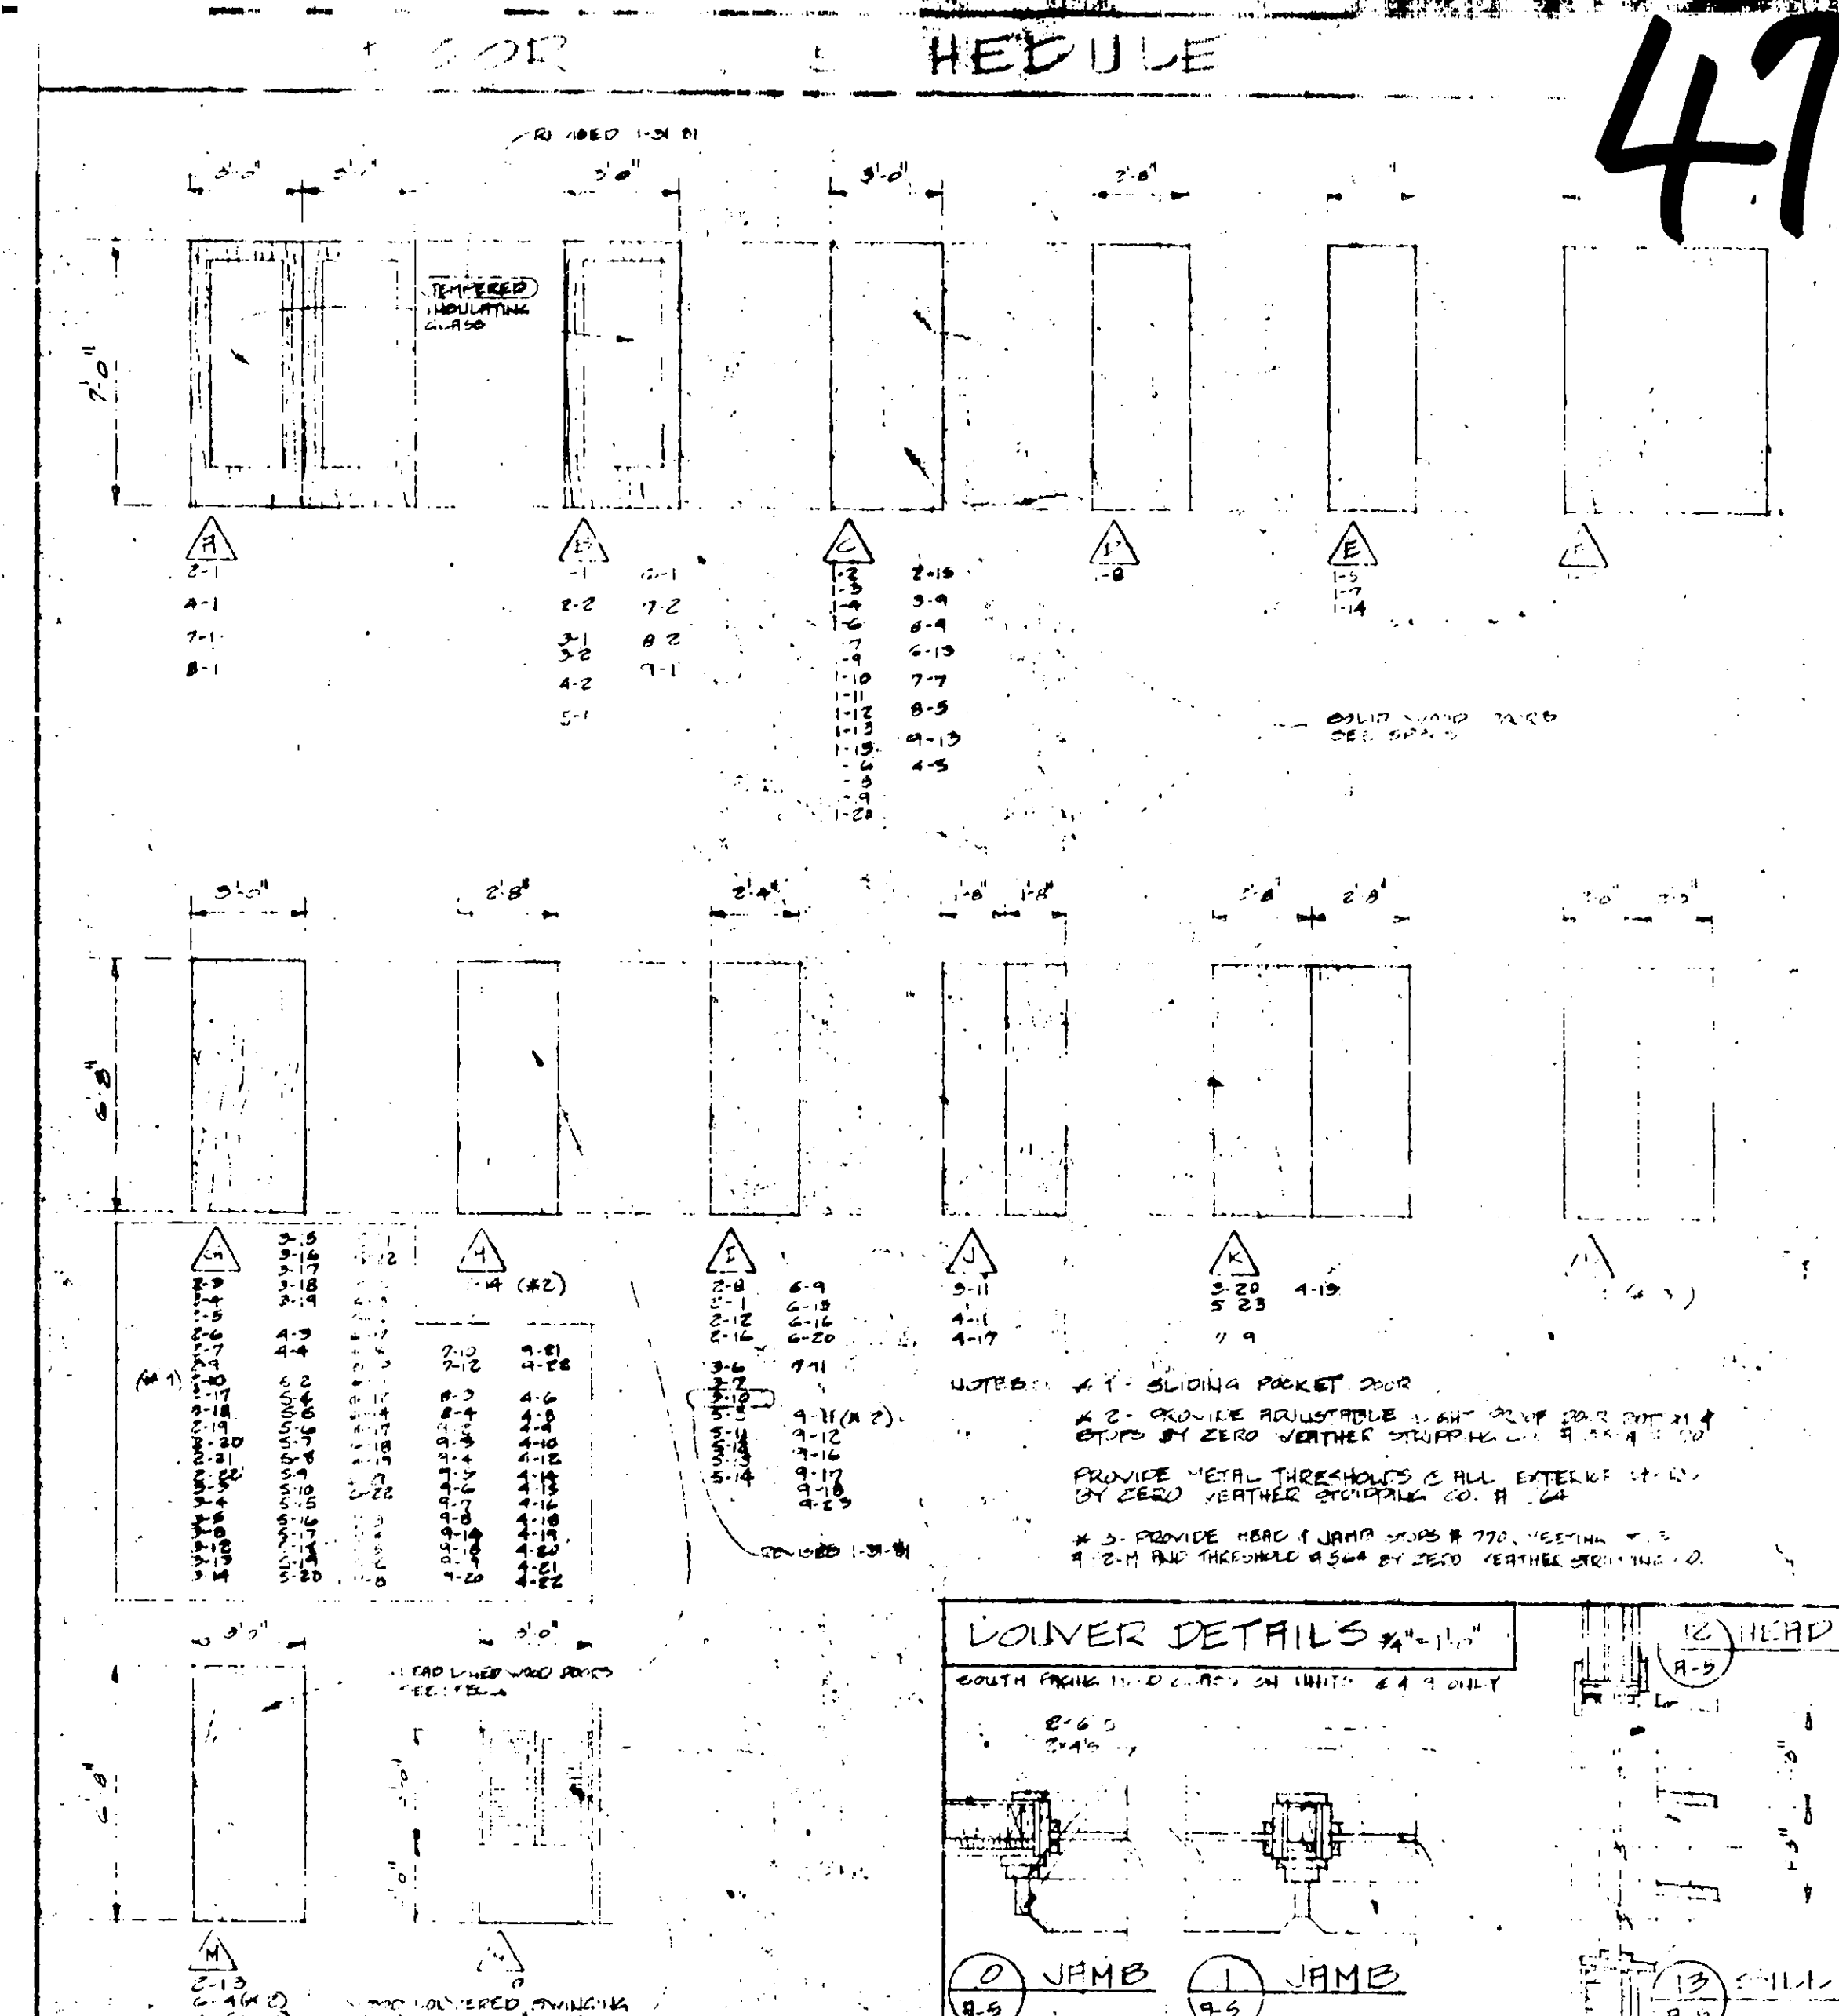

**MEDICAL VILLAGE** MEDICAL VILLAGE DRIVE FAYETTEVILLE, NORTH CAROLINA  
**JAMES A. CLAYWELL, ARCHITECT** 1012 WESTMONT DRIVE FAYETTEVILLE, NORTH CAROLINA 28305 919-485-3790

FLOOR PLAN - UNIT 3  
 DOOR SCHEDULE / WINDOW DETAILS  
 SCALE: AS SHOWN  
 DRAWN BY: JAC  
 CHECKED BY: RAW  
 APPROVED BY: JAC  
 DATE: FEB 21, 1980  
 JOB NO. 8001


**JAMES A. CLAYWELL ARCHITECT**  
 3414 NORTH CAROLINA FAYETTEVILLE, N.C.

**A5**  
 OF 14

Condo 3. 47

48

48

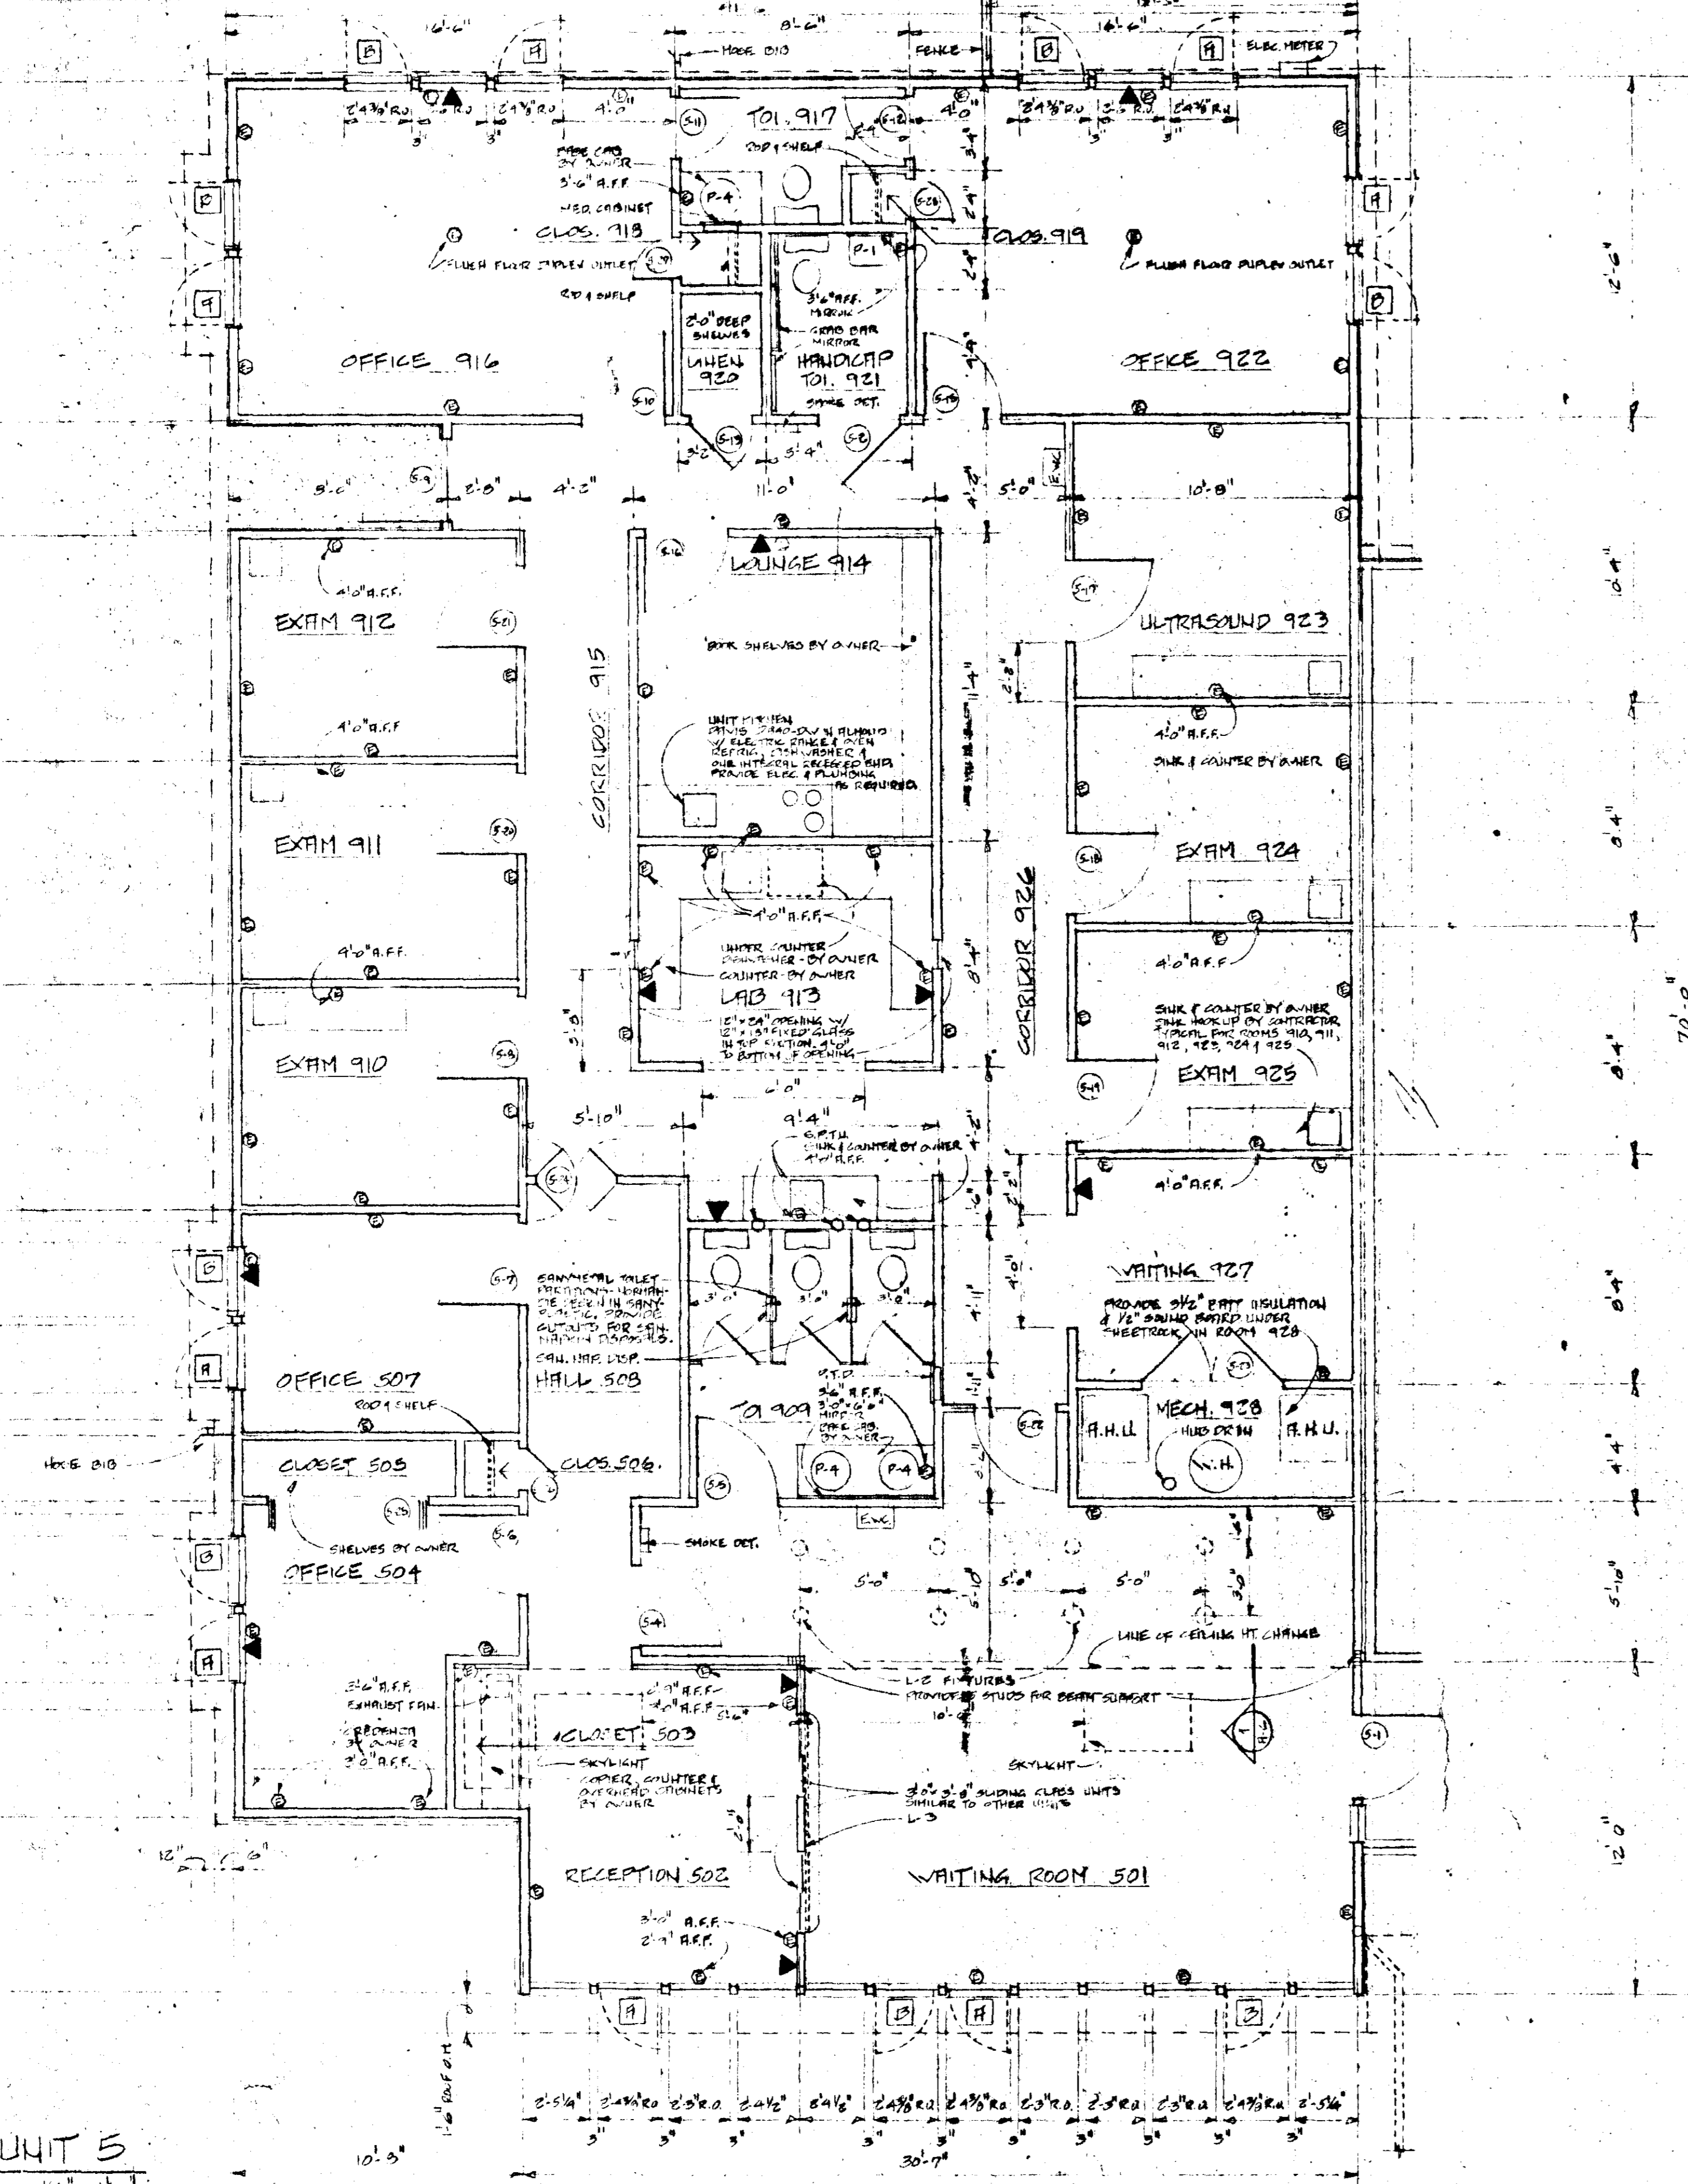

NOTES:

COUNTERS & SINKS INDICATED AS "BY OWNER" SHALL BE PROVIDED & INSTALLED BY OWNER BUT THE SINKS SHALL BE CONNECTED BY CONTRACTOR.

DOOR # 5-3 & 5-14 HAVE BEEN OMITTED FROM ORIGINAL PLAN. DOOR # 5-24, 5-25, 5-26, 5-27 & 5-28 HAVE BEEN RELOCATED AS FOLLOWS:

5-24 - SIMILAR TO DOOR # 7-10.  
 5-25 - 6'-0" x 6'-0" 6 LEAF WOOD LAMINATED BUILDING DOOR.  
 5-26, 5-27, 5-28 - 1'-6" x 6'-0" SLID WOOD DOOR.


AS DOOR # 5-23 PROVIDE HEAD & JAMB STOPS # 770, MEETING STILE # 52-M & THRESHOLD # 524 BY ZERO WEATHER STOPPING CO.

PROVIDE 2 # 3605-30 LIGHT FIXTURES AND MIRROR IN ROOM 909 IN LIEU OF ONE IN ADDITION TO # 3705-30 FIXTURE.

TRAILER ACCESSORIES IN EXAM 909 SHALL INCLUDE THE FOLLOWING:

- 3 TABLE PAPER HOLDERS - PARKER NO. 464
- 1 PAPER TOWEL DISPENSER (P.T.D.) - PARKER NO. 654
- 1 WALL MIRROR - PARKER NO. 3005 - 26" HIGH x 22" LONG.
- 3 GREAT HOOKS (4 POSITION PAPER) - PARKER NO. 1224
- 1 THRU WALL SANITARY WIPER DISPOSAL - PARKER NO. 653
- 1 END WALL SANITARY WIPER DISPOSAL - PARKER NO. 653ES


**MEDCO CONDOMINIUMS**  
 J.J. ROSE, ARCHITECT  
 1981

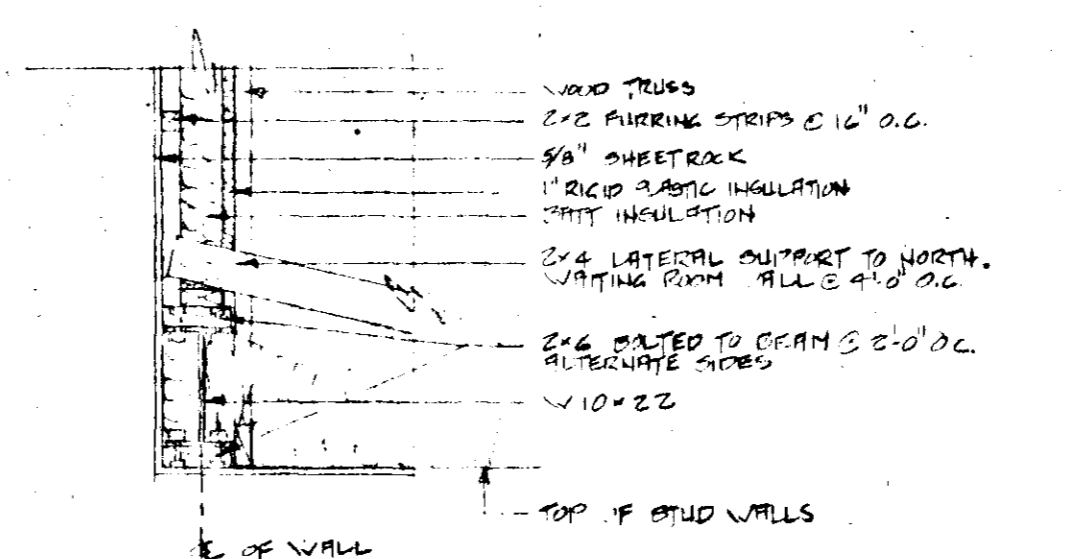

1 WAITING ROOM 501 CEILING SUPPORT  
 1/2" x 1'-0"


REVISED FLOOR PLAN - UNIT 5  
 SCALE: 1/4" = 1'-0"  
 11 FINISH LOCATIONS - THIS UNIT

<b>MEDICAL VILLAGE</b> MEDICAL VILLAGE DRIVE FAYETTEVILLE, NORTH CAROLINA		<b>FLOOR PLAN - UNIT 5</b> REVISED		DRAWN BY: JAC CHECKED BY: RGV APPROVED BY: JAC
<b>JAMES A. CLAYWELL, ARCHITECT</b> 1012 WESTMONT DRIVE FAYETTEVILLE, NORTH CAROLINA 28305 919-485-3780		SCALE: 1/4" = 1'-0"		DATE: APRIL 17, 1981 REV. MAY 5, 1981 JOB NO. 8201

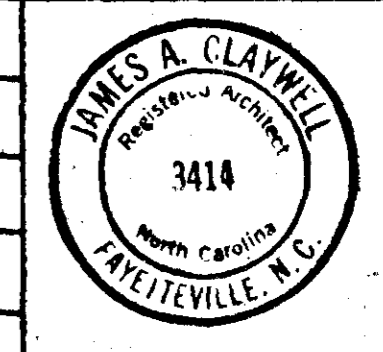

**REVISIONS**  
 A6  
 OF 14

Condo 2-48

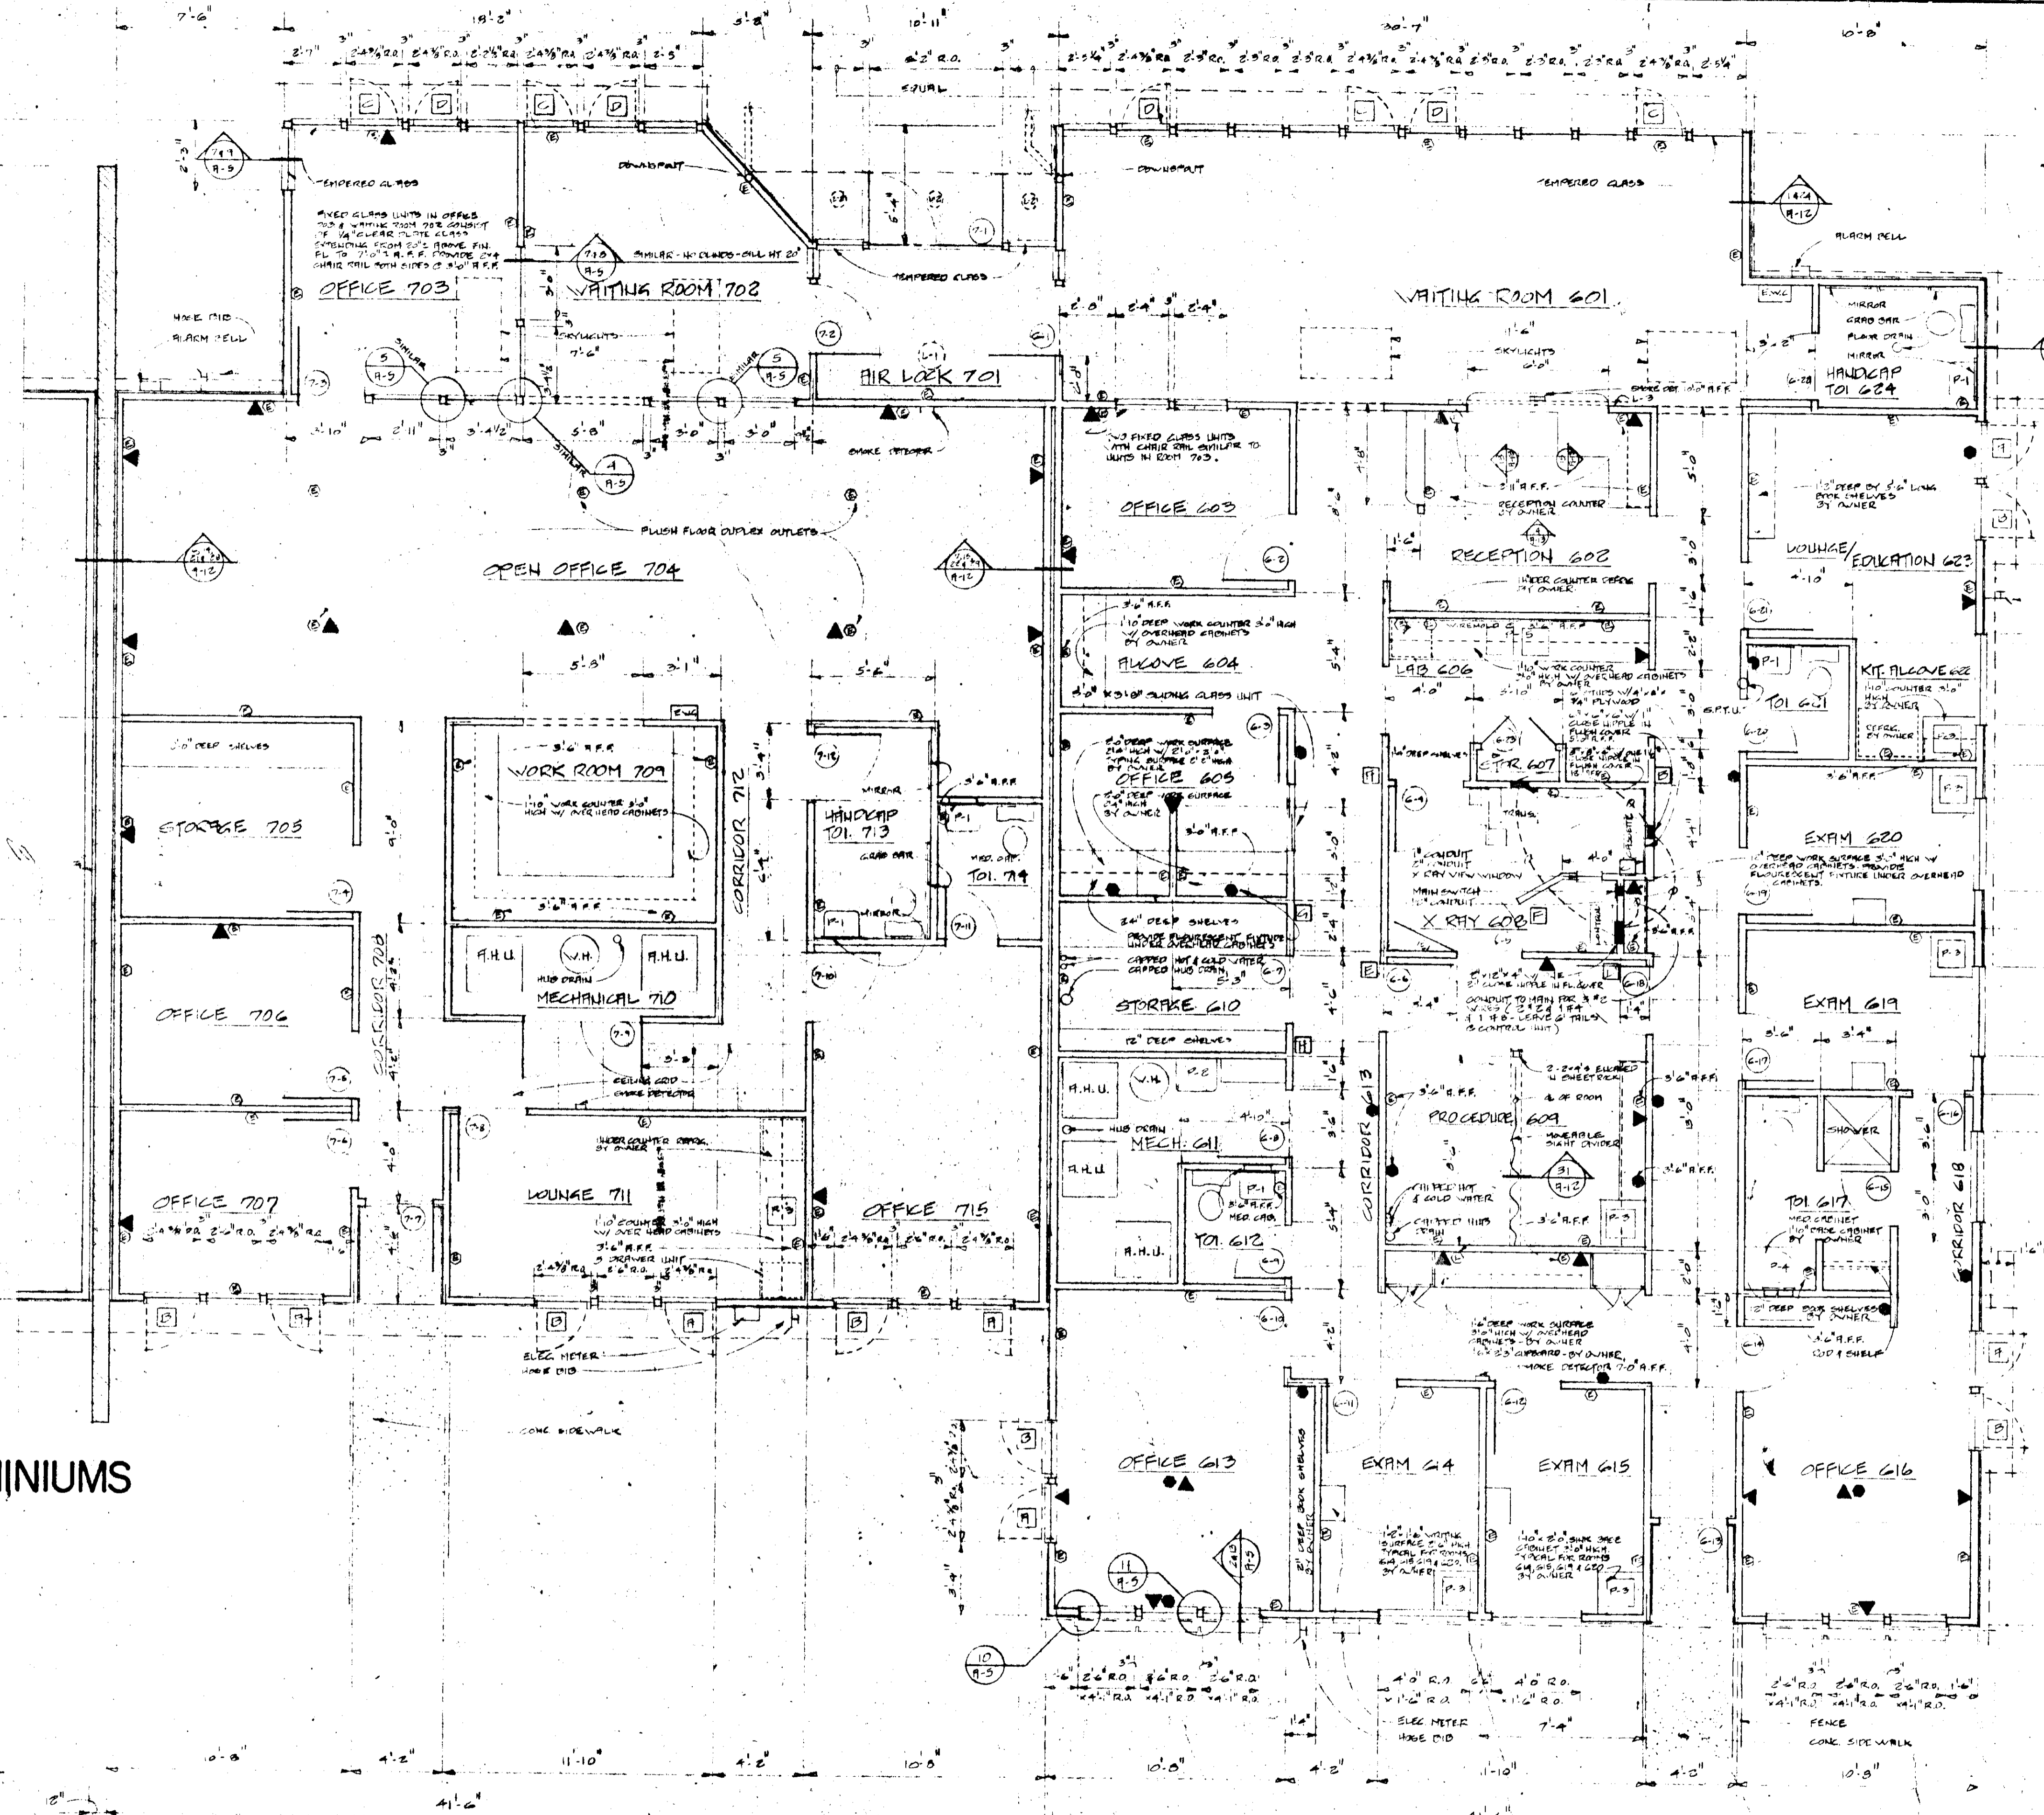

**LEAD X-RAY REQUIREMENTS**

TRANSFORMER, CONTROL PANEL & CONTROL UNIT IN ROOM 604 SHALL BE PROVIDED & INSTALLED BY OWNER. 2000 WATTAGE EQUIPMENT INSTALLER TO INSURE PROPER INSTALLATION. EQUIPMENT INSTALLER WILL BE PROTECT HEADS - TEL ROOM 600A.

MAIN SWITCH TO BE FED BY 2 WIRE. MAIN WIRE TO BE IDENTIFIED BY MARKING 9-0 W/ WHITE NEUTRAL & GREEN GROUND (NEVER INVERT).

SHOUT CABLE HAVE NO UNITS UNDER. ALL WIRE SHALL BE COVER.

LINE VOLTAGE - 277/120 VOLTS 3 WIRE SYSTEM.

MINIMUM LOAD - 200/2 KILOWATTS. MAIN SWITCH (CIRCUIT BREAKER) TO BE 100 AMP.

MAX. CURRENT DRAWN AT LOAD 160 AMP. STANDING CURRENT DRAWN TO BE 4 AMP. AVAILABLE VOLTAGE TO BE 115 VOLTS.

PROVIDE LEAD SHIELDING IN THE PATH OF LEAD LINED SYSTEM. LEAD LINED IN ROOMS 609 & 610 TO FOLLOW:

WALL PENETRATION	LEAD THICKNESS
A-B	1.5 MM
B-C	1.5 MM
C-D	3.5 MM
D-E	1.5 MM
DOOR 6-5	1.5 MM
E-F	1.5 MM
G-H	1.0 MM
VIEW WINDOW	1.0 MM
DOOR 6-7	1.5 MM
DOOR 6-7	1.5 MM

SEE DIV. 28 & DIV. 13 FOR PROTECT ROOMS - ALL REQUIREMENTS.

**X RAY NOTES:**

TRANSFORMER, CONTROL PANEL & CONTROL UNIT IN ROOM 604 SHALL BE PROVIDED & INSTALLED BY OWNER. 2000 WATTAGE EQUIPMENT INSTALLER TO INSURE PROPER INSTALLATION. EQUIPMENT INSTALLER WILL BE PROTECT HEADS - TEL ROOM 600A.

MAIN SWITCH TO BE FED BY 2 WIRE. MAIN WIRE TO BE IDENTIFIED BY MARKING 9-0 W/ WHITE NEUTRAL & GREEN GROUND (NEVER INVERT).

SHOUT CABLE HAVE NO UNITS UNDER.

**FLOOR PLAN - UNIT-6**  
SCALE: 1/4" = 1'-0"  
19 PHONE LOCATIONS - THIS UNIT

**MEDCO CONDOMINIUMS**  
J. J. ROSE, ARCHITECT  
1981

**FLOOR PLAN - UNIT 7**  
SCALE: 1/4" = 1'-0"  
14 PHONE LOCATIONS - THIS UNIT


**MEDICAL VILLAGE** MEDICAL VILLAGE DRIVE FAYETTEVILLE, NORTH CAROLINA  
**JAMES A. CLAYWELL, ARCHITECT** 1012 WESTMONT DRIVE FAYETTEVILLE, NORTH CAROLINA 28305 919-485-3780

**FLOOR PLAN - UNITS 6 & 7**  
REVISED  
SCALE: 1/4" = 1'-0"

DRAWN BY: J.A.C.  
CHECKED BY: R.A.W.  
APPROVED BY: J.A.C.  
DATE: FEB. 6 1981  
JOB NO. 8001


**JAMES A. CLAYWELL**  
REGISTERED ARCHITECT  
3414  
FAYETTEVILLE, N.C.

**REVISED**  
OF 14

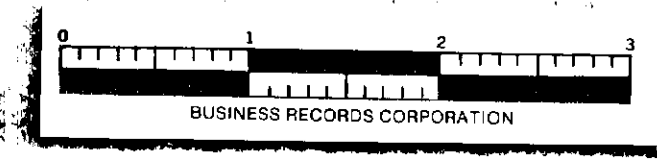

Condo 2-49

50

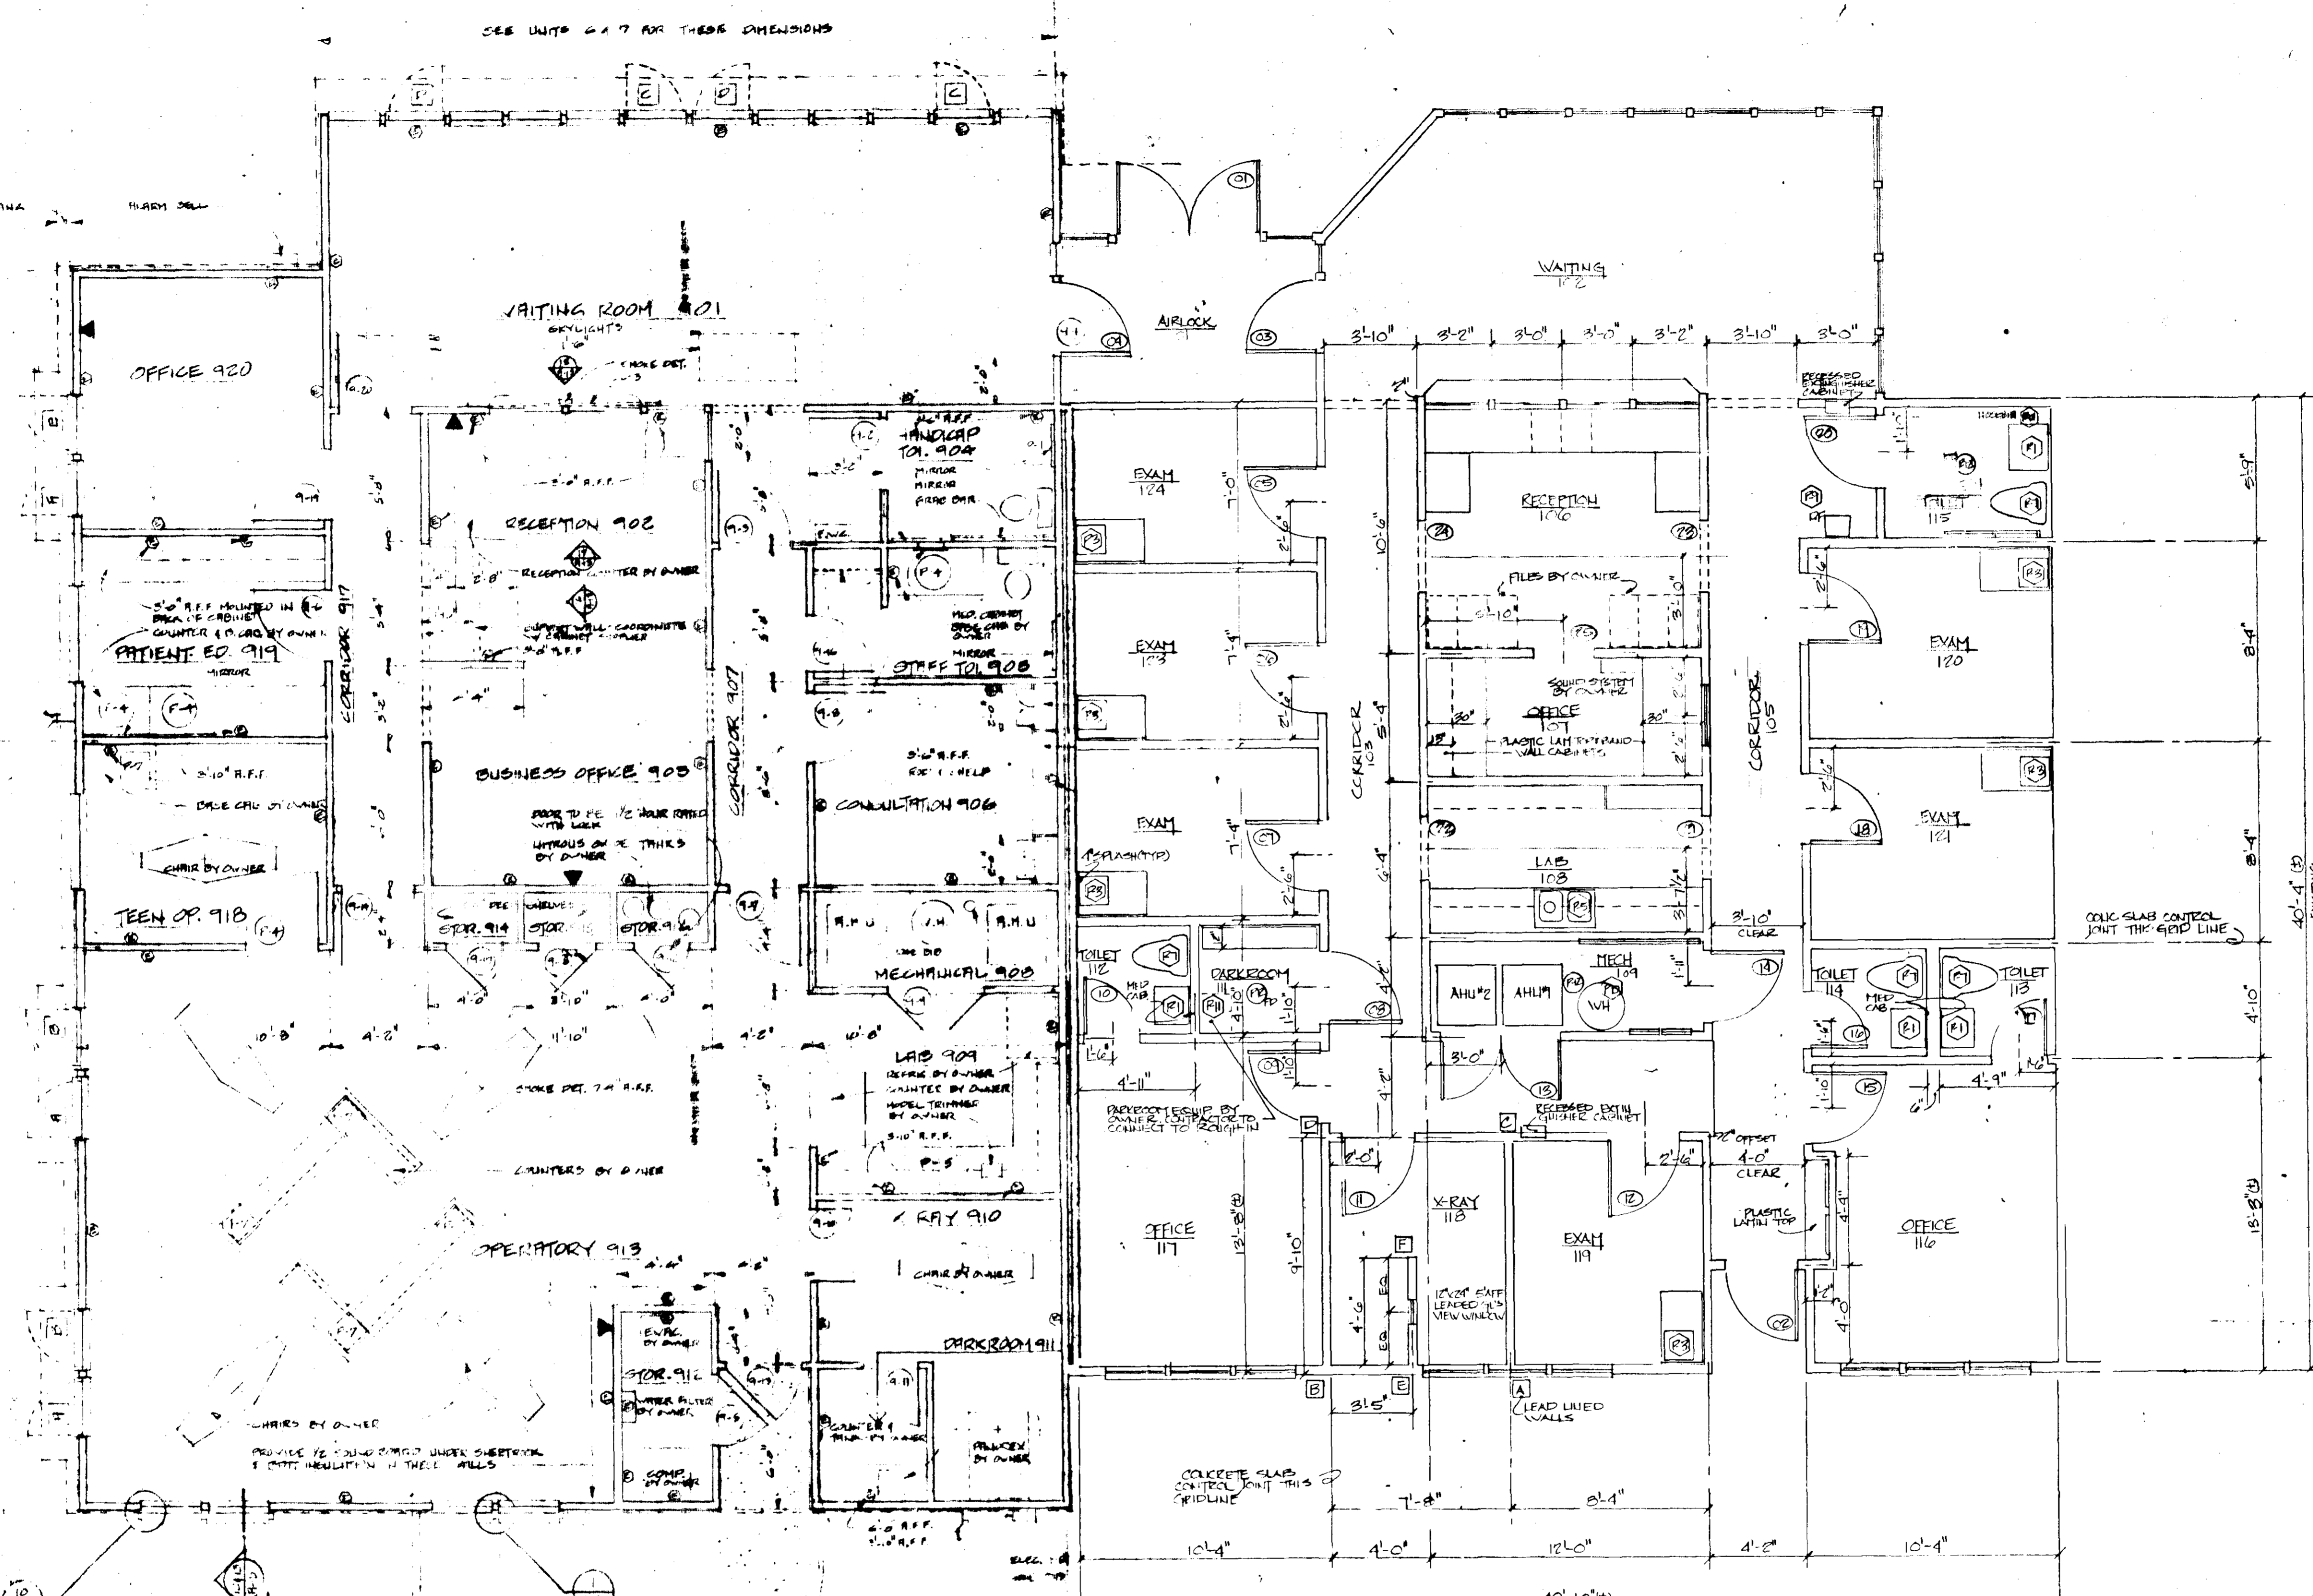

NOTES:

1. PROVIDE PLUMBING ELECTRICAL & MECHANICAL WORK SHOWN HEREIN IN ACCORDANCE WITH THE SPECIFICATIONS AND NOTES ON SHEET 9B-1. ALL WORK SHALL BE IN ACCORDANCE WITH THE LATEST EDITIONS OF THE NATIONAL PLUMBING, ELECTRICAL & MECHANICAL CODES.

2. PROVIDE ALL NECESSARY MATERIALS & LABOR FOR THE WORK SHOWN HEREIN. ALL MATERIALS SHALL BE APPROVED BY THE ARCHITECT BEFORE INSTALLATION.

3. PROVIDE ALL NECESSARY CONNECTIONS TO EXISTING WORK. ALL WORK SHALL BE DONE IN ACCORDANCE WITH THE LATEST EDITIONS OF THE NATIONAL PLUMBING, ELECTRICAL & MECHANICAL CODES.

4. PROVIDE ALL NECESSARY PROTECTIVE WORK TO BE MAINTAINED THROUGHOUT THE CONSTRUCTION OF THIS UNIT.

5. PROVIDE ALL NECESSARY FINISHES TO BE SHOWN ON SHEET 9B-1.

6. PROVIDE ALL NECESSARY SCHEDULING TO BE SHOWN ON SHEET 9B-1.

7. PROVIDE ALL NECESSARY SCHEDULING TO BE SHOWN ON SHEET 9B-1.

8. PROVIDE ALL NECESSARY SCHEDULING TO BE SHOWN ON SHEET 9B-1.

9. PROVIDE ALL NECESSARY SCHEDULING TO BE SHOWN ON SHEET 9B-1.

10. PROVIDE ALL NECESSARY SCHEDULING TO BE SHOWN ON SHEET 9B-1.

REVISIONS:

REVISED FLOOR PLAN UNIT 9B

DATE: APRIL 17, 1981

REVISION: 5-8-81 (2)


JAC

**MEDCO CONDOMINIUMS**  
 J.J. ROSE, ARCHITECT  
 1981


FLOOR PLAN - UNIT 9B

<b>MEDICAL VILLAGE</b>		MEDICAL VILLAGE DRIVE FAYETTEVILLE, NORTH CAROLINA		DRAWN BY: JAC	
<b>JAMES A. CLAYWELL, ARCHITECT</b>		1012 WESTMONT DRIVE FAYETTEVILLE, NORTH CAROLINA 28305 919-485-3780		CHECKED BY: JAC	
				APPROVED BY: JAC	
				DATE: APRIL 17, 1981	
				REVISION: 5-8-81 (2)	
				JOB NO. 8021	
		SCALE: 1/4" = 1'-0"			
				<b>18</b> REVISED OF 14	

Condo 2 - 50

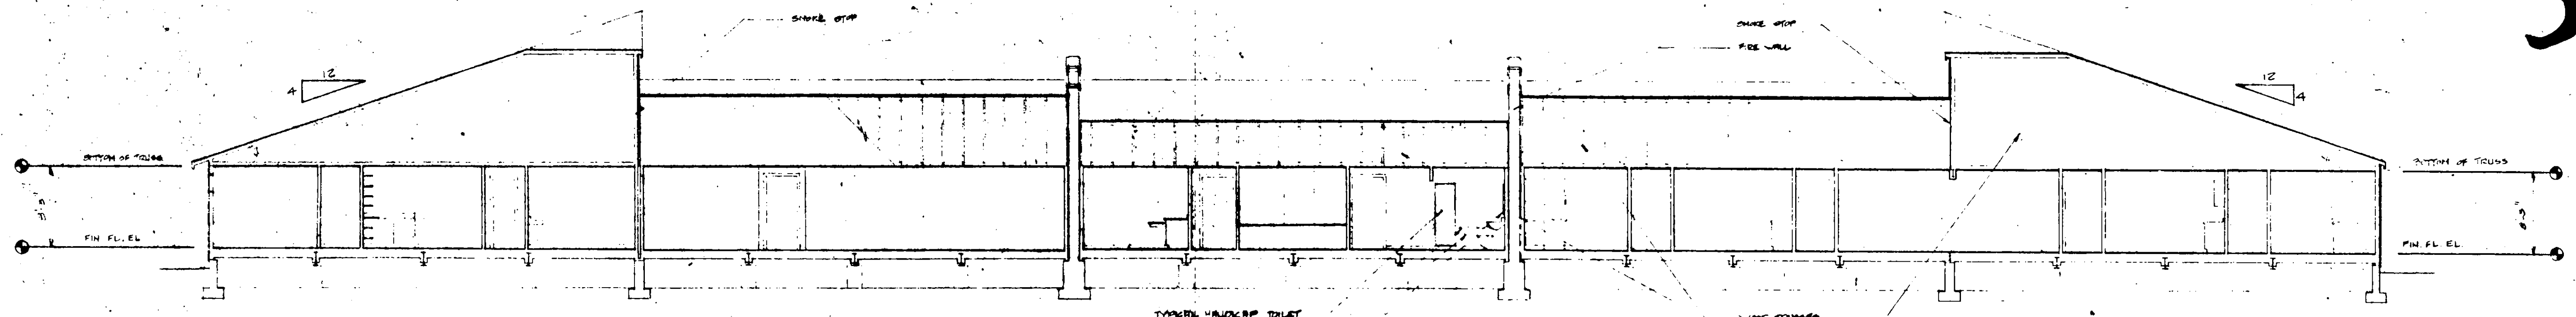


1 LONGITUDINAL SECTION - UNITS 1 THRU 5  
A-11 SCALE: 1/8" = 1'-0"

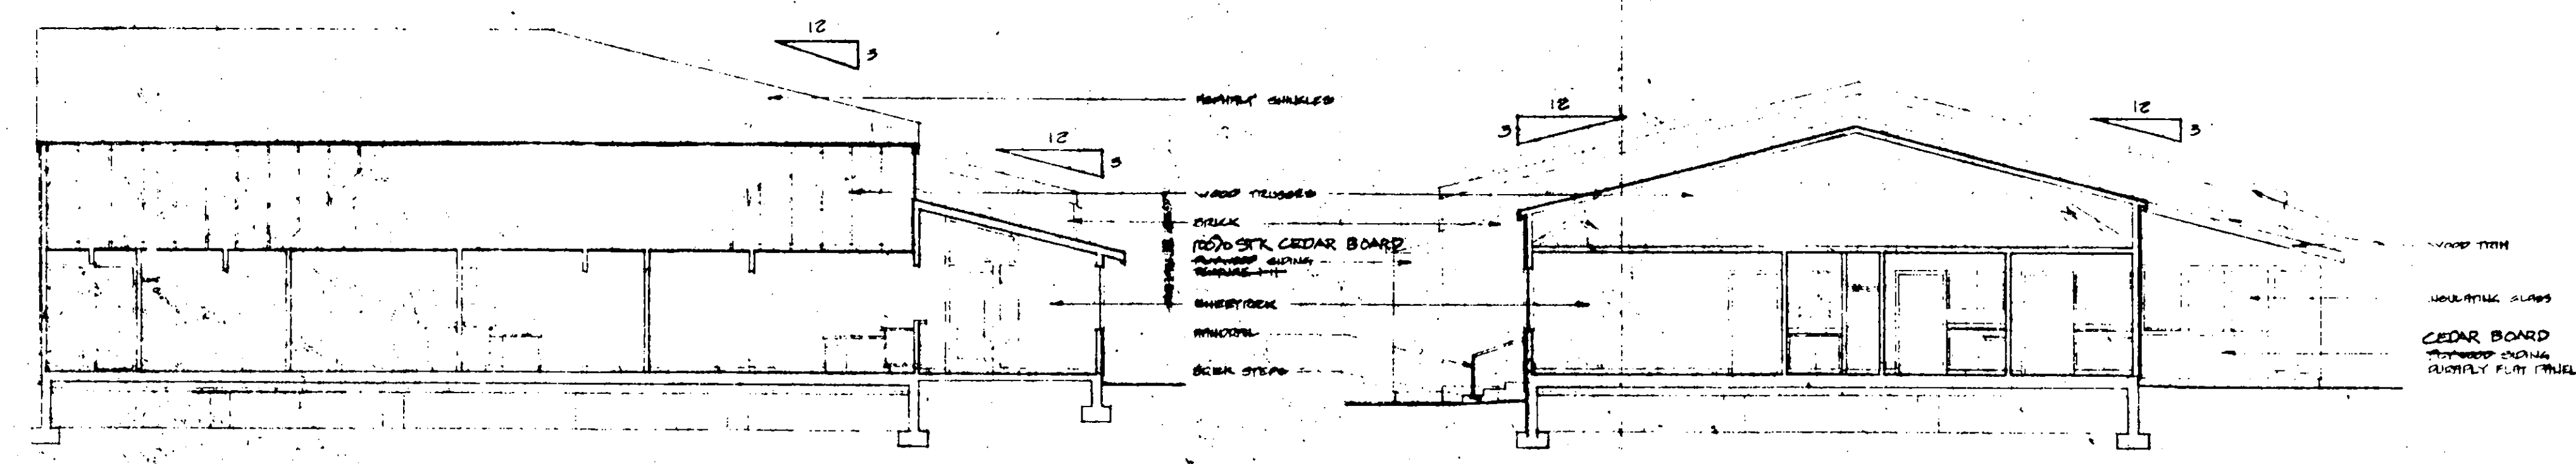


2 TRANSVERSE SECTION - UNIT 5  
A-11 SCALE: 1/8" = 1'-0"

3 TRANSVERSE SECTION - UNIT 3  
A-11 SCALE: 1/8" = 1'-0"

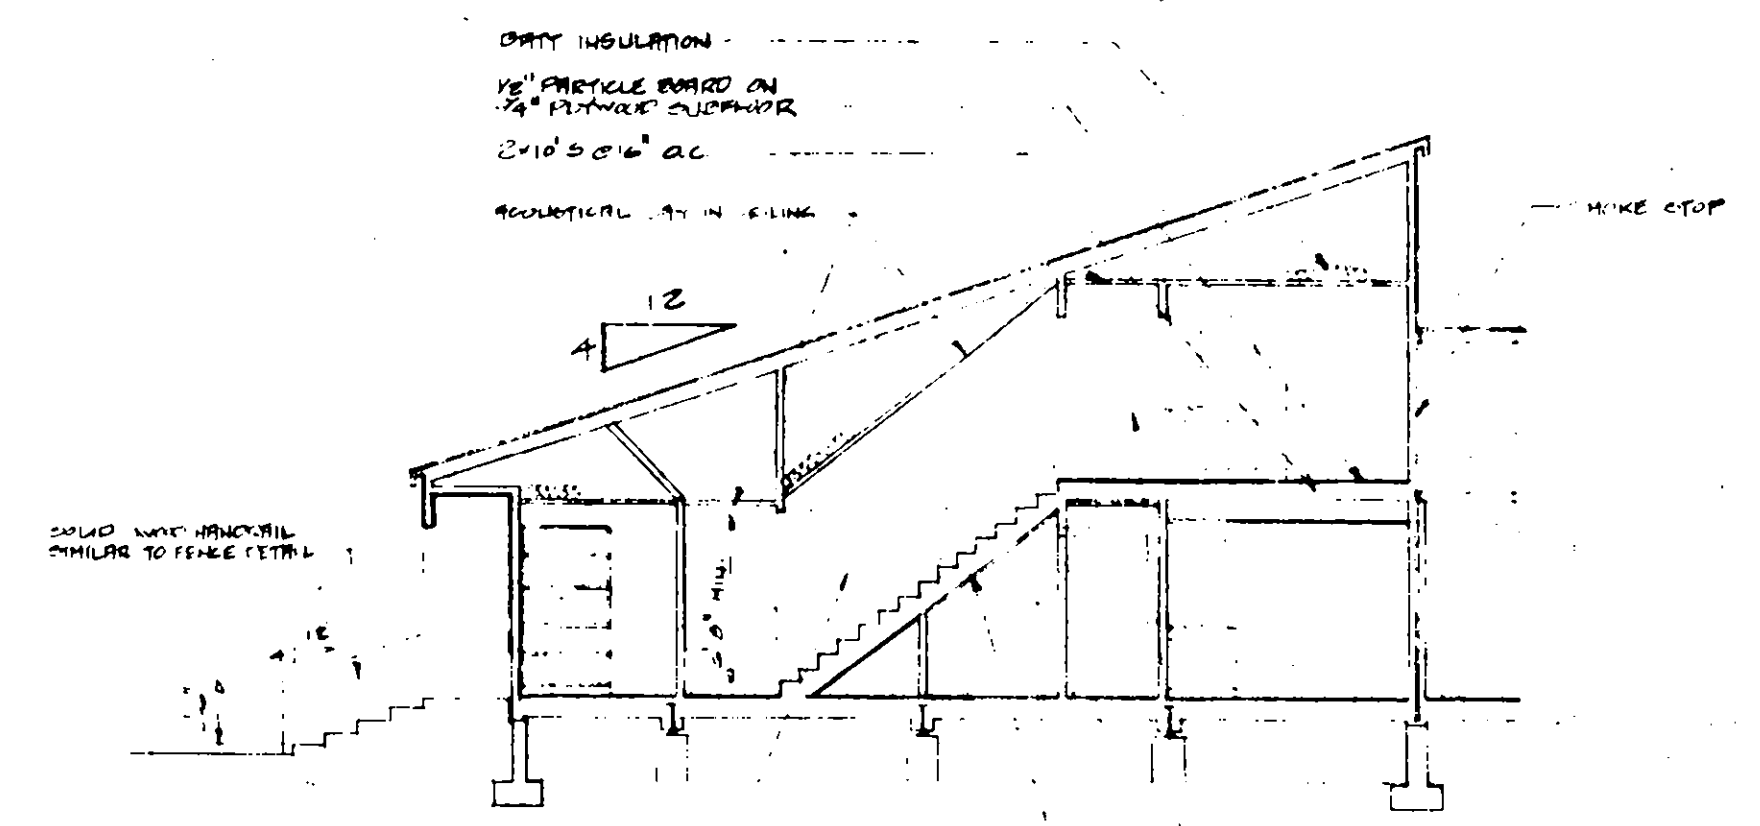

6 LONGITUDINAL SECTION - UNIT 9  
A-11 SCALE: 1/8" = 1'-0"

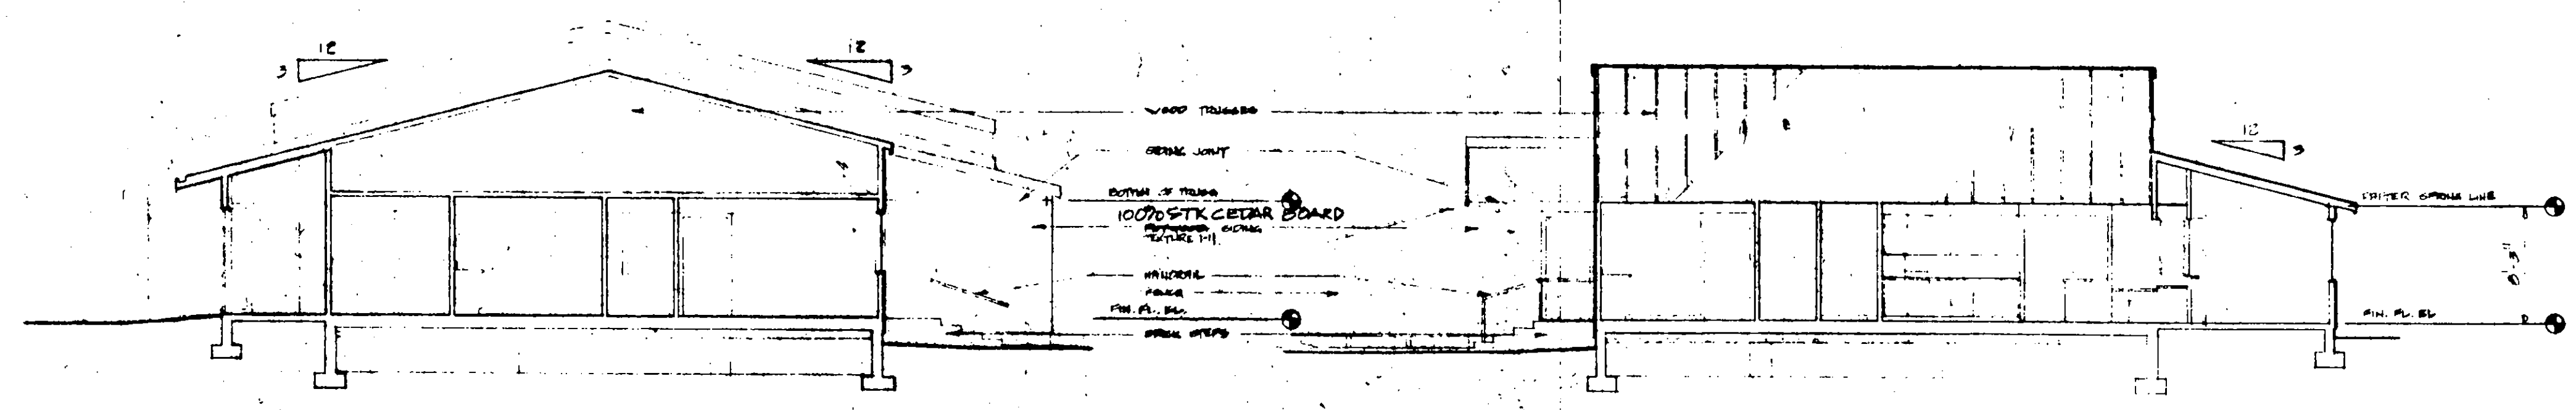

4 TRANSVERSE SECTION - UNIT 2  
A-11 SCALE: 1/8" = 1'-0"

5 TRANSVERSE SECTION - UNIT 4  
A-11 SCALE: 1/8" = 1'-0"

MEDCO CONDOMINIUMS  
J. J. ROSE, ARCHITECT  
1981

MEDICAL VILLAGE MEDICAL VILLAGE DRIVE FAYETTEVILLE, NORTH CAROLINA  
JAMES A. CLAYWELL, ARCHITECT 1012 WESTMONT DRIVE FAYETTEVILLE, NORTH CAROLINA 28305 919-485-3780

BUILDING SECTIONS  
SCALE: 1/8" = 1'-0"


DRAWN BY: SSA+JAC  
CHECKED BY: R.A.M.  
APPROVED BY: J.A.C.  
DATE: FEB. 31, 1983  
REV. FEB. 6, 91  
JOB NO. 8001



A11 OF 14

Condo 2 - 51

52

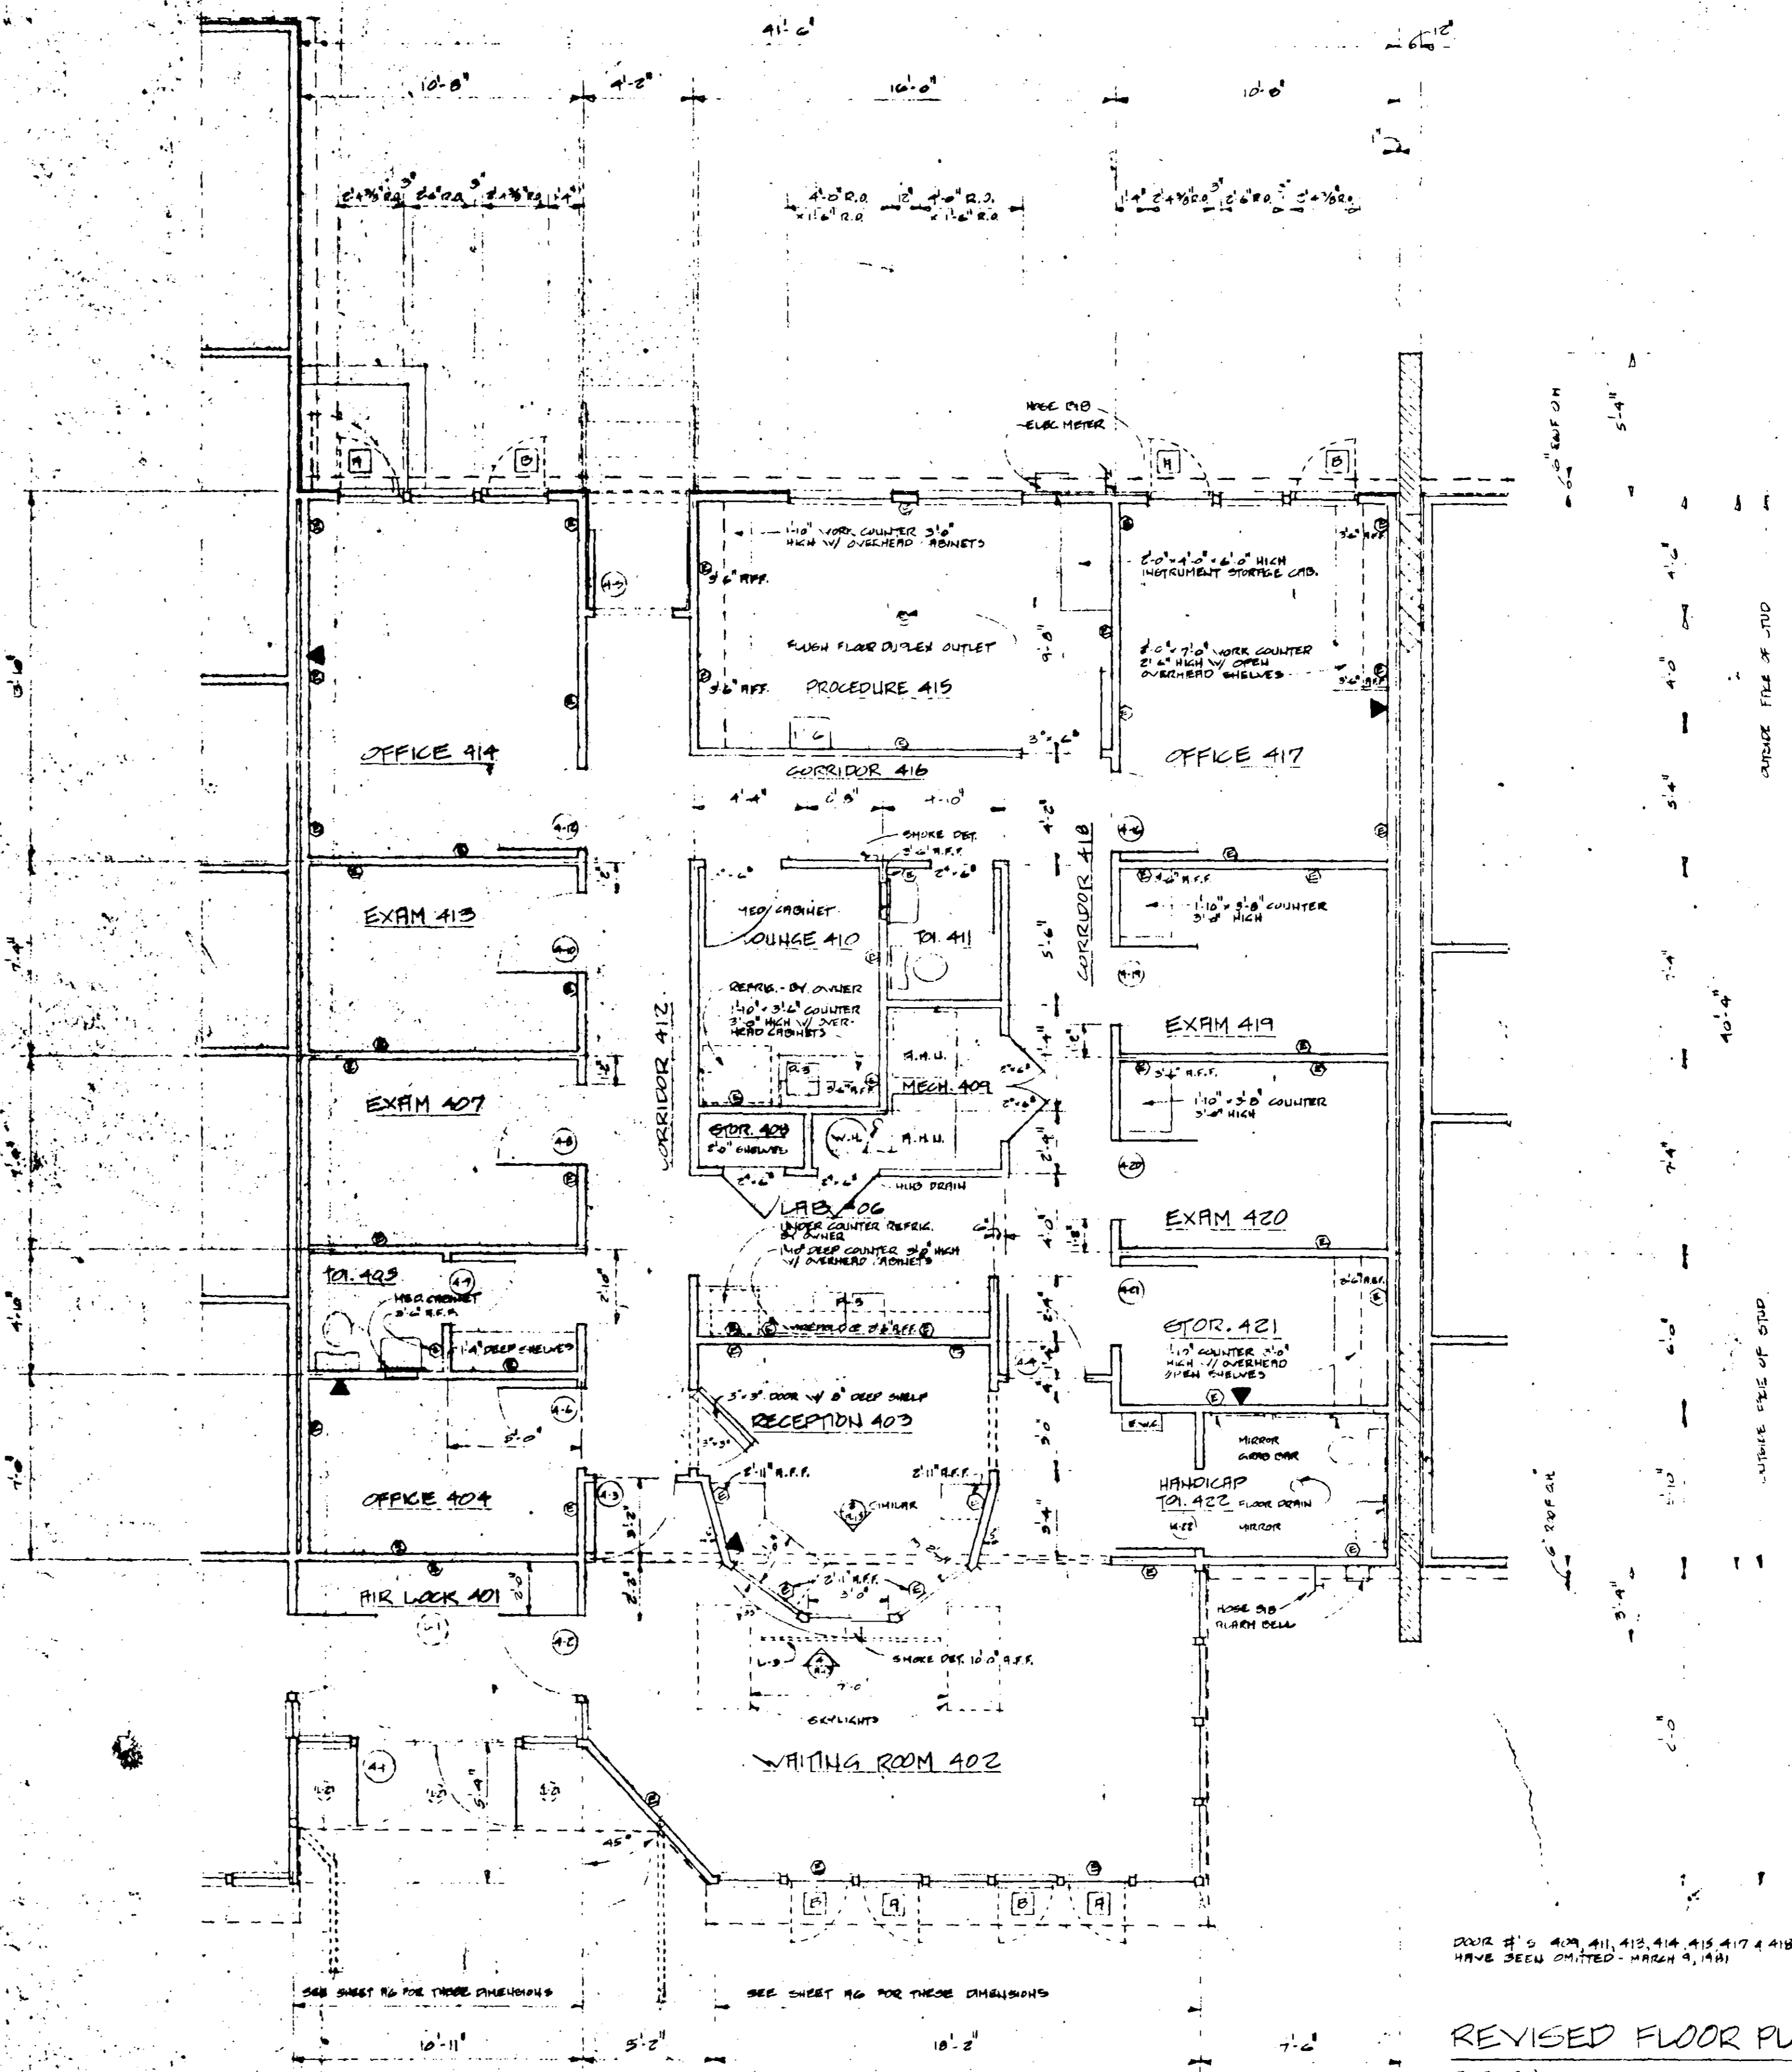

MEDCO CONOMINIUMS  
 J. J. ROSE, ARCHITECT  
 1981

DOOR # 0 409 411 413 414 415 417 418  
 HAVE BEEN OMITTED - MARCH 9, 1981

REVISED FLOOR PLAN - UNIT 4  
 SCALE: 1/4" = 1'-0"


MEDICAL VILLAGE MEDICAL VILLAGE DRIVE FAYETTEVILLE, NORTH CAROLINA

JAMES A. CLAYWELL, ARCHITECT 1012 WESTMONT DRIVE FAYETTEVILLE, NORTH CAROLINA 28305 919-485-3780

REVISED FLOOR PLAN - UNIT 4

SCALE: 1/4" = 1'-0"

DRAWN BY: JAC  
 CHECKED BY: R.G.W.  
 APPROVED BY: JAC  
 DATE: FEB. 6, 1981  
 REV. NO.: 31 MAY 5, 1988  
 JOB NO.: 0001

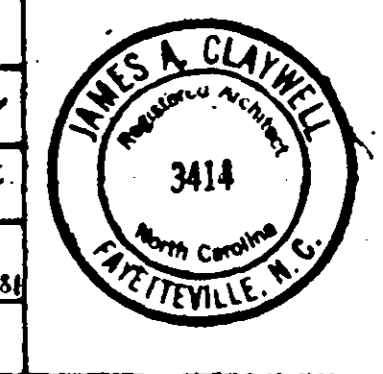



A14  
 OF 14

Condo 2-52



195

MEDICAL VILLAGE SECTION 3  
P.B. 55, PG. 34  
See Deed Book 3368, Page 0203 For  
Recorded Easement To Utilize Seven (7) Parking Spaces

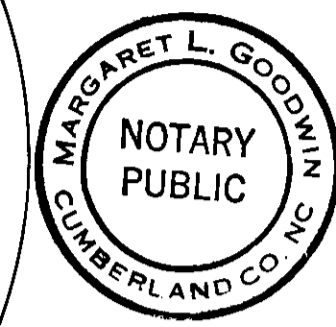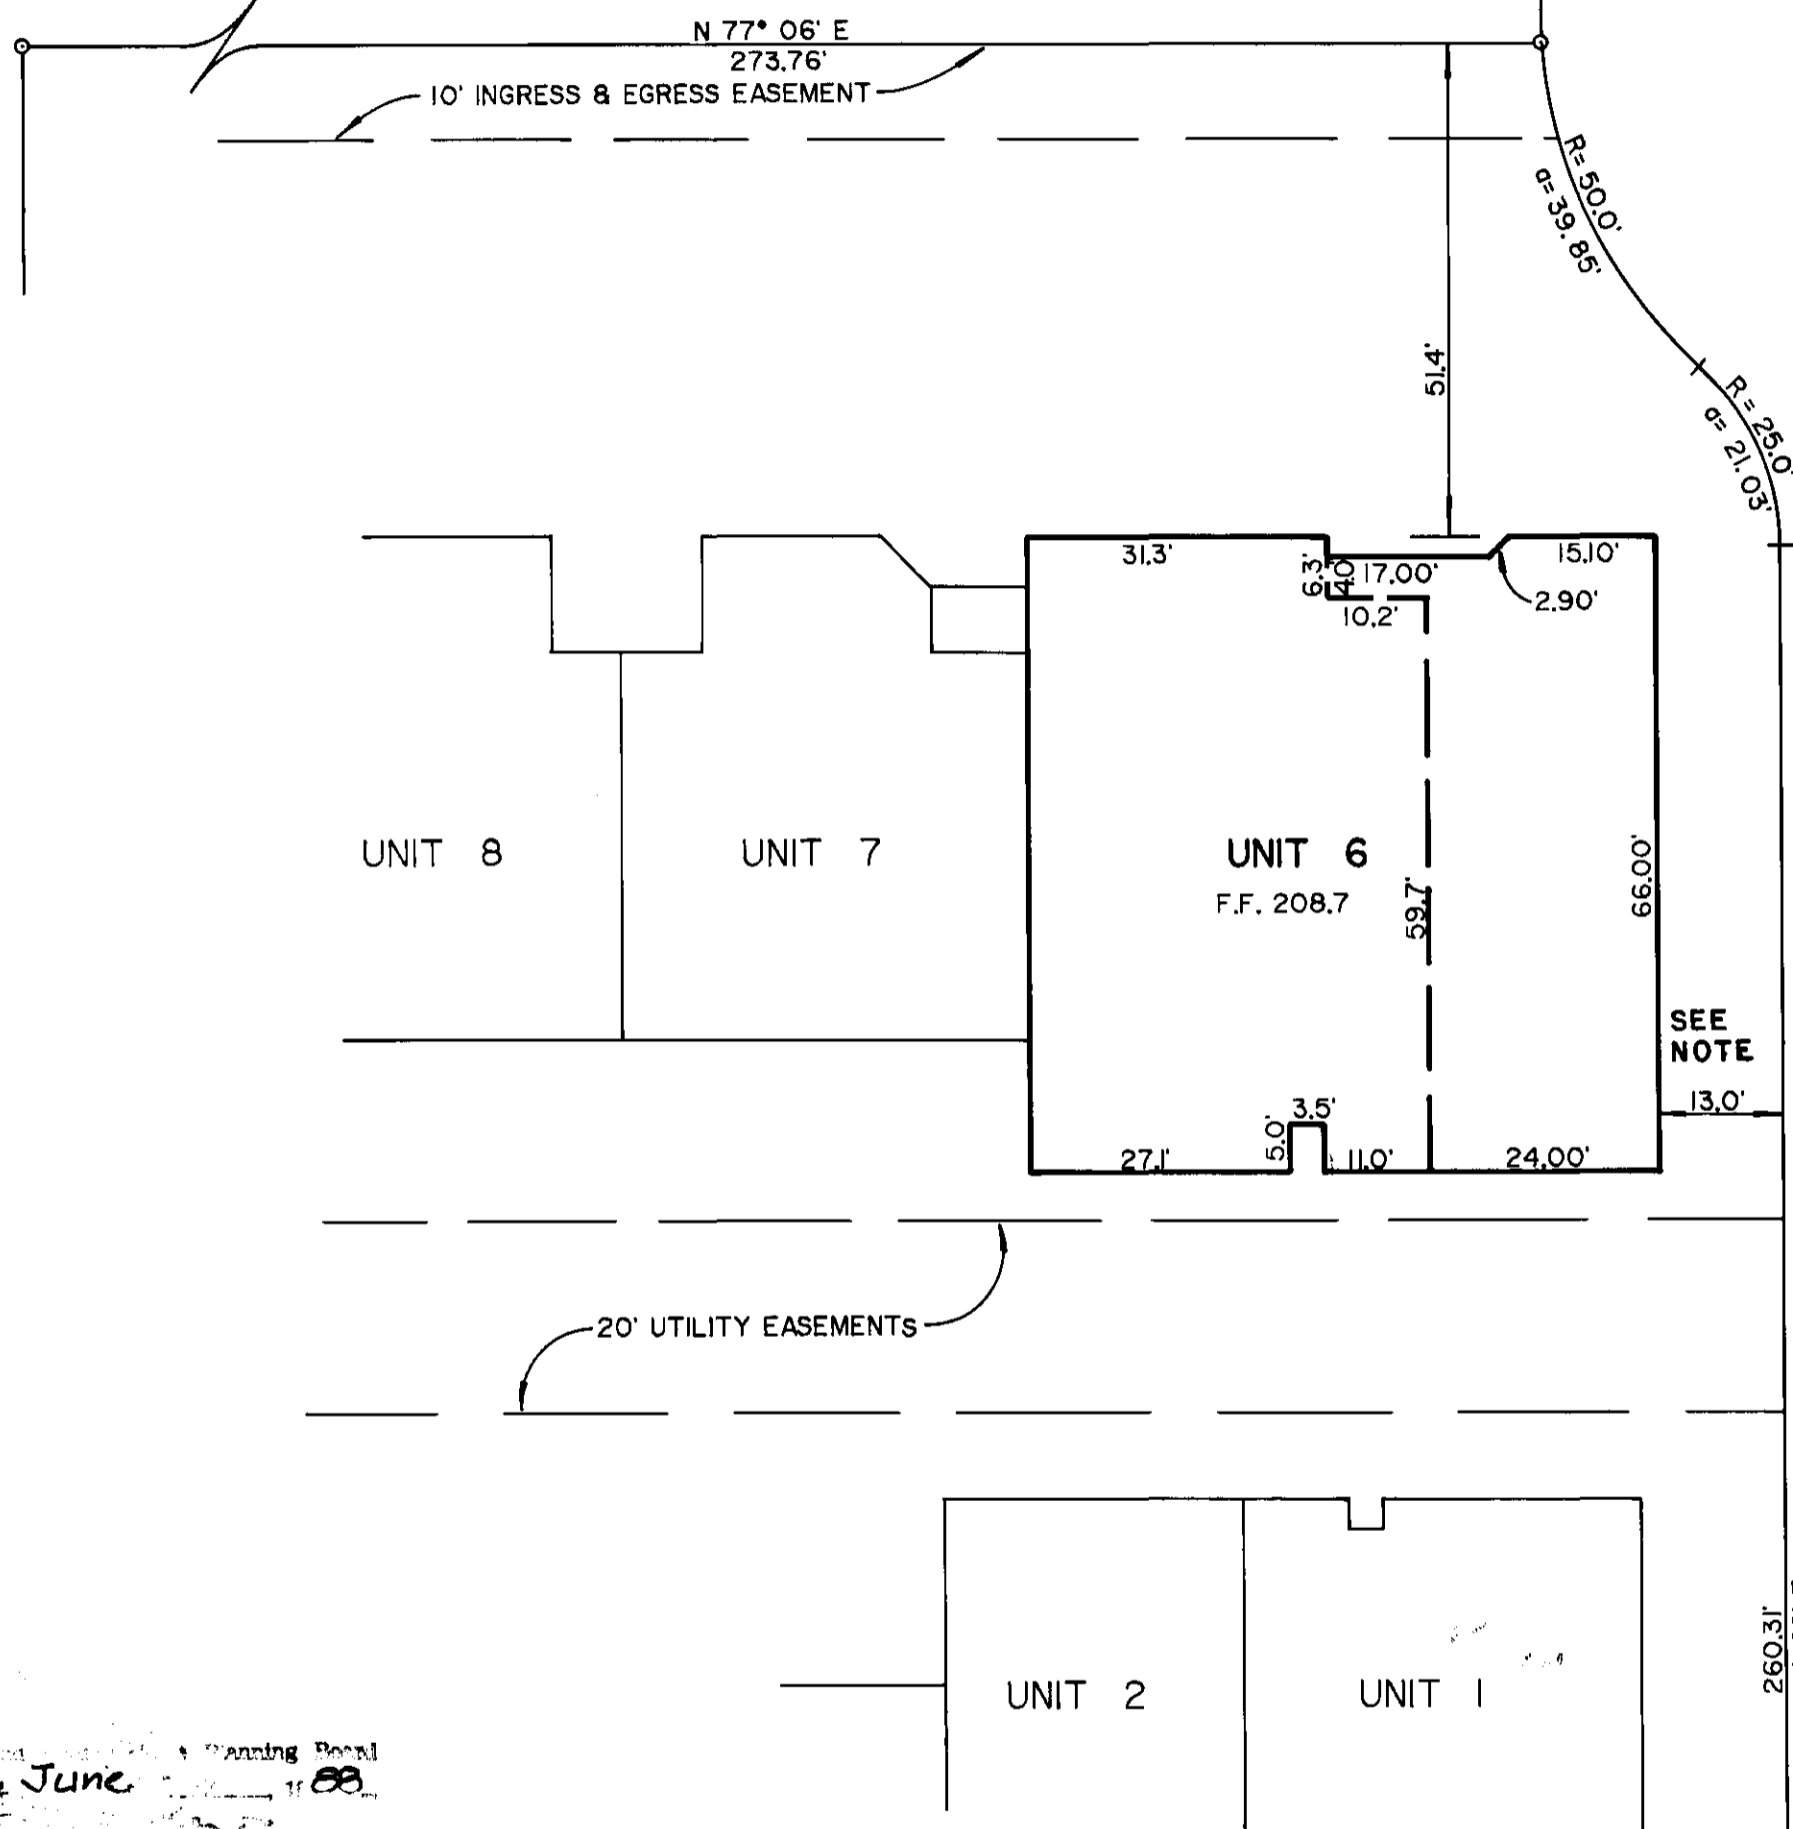

State of North Carolina CUMBERLAND County  
I, JAMES M. KIZER, certify that this map was drawn  
from an actual survey made by me (deed description recorded in Book  
Page Book Page); that the error of closure  
as calculated by latitudes and departures is 1: 5000; that the bound-  
aries not surveyed are shown as broken lines plotted from information  
found in Book Page; that this map was prepared in accord-  
ance with G.S. 47-30, as amended. Witness my hand (and stamp or seal)  
this 14th day of JUNE A.D. 1988  
Seal or Stamp [Signature]  
Registration Number L-2243

State of North Carolina CUMBERLAND County  
I, a Notary Public of the County and State aforesaid, certify that  
JAMES M. KIZER, a registered land surveyor, personally appeared  
before me this day and acknowledged the execution of the foregoing  
instrument. Witness my hand and official stamp or seal, this 14th  
day of JUNE A.D. 1988  
Seal or Stamp [Signature]  
My commission expires March 20, 1990



I, JAMES M. KIZER, Professional Engineer of North Carolina,  
No. 4783, certify that the attached plat map entitled "Medco  
Condominiums" and three (3) pages of plans and drawings  
fully and accurately depict the layout, unit numbers, location,  
floor elevations, (see architectural plans for varying ceiling  
heights) and dimensions of the condominium units as built, of  
Medco Condominiums, and that said attached plans and draw-  
ings are accurate copies of portions of the plans as filed  
with and approved by the Cumberland County Joint  
Planning Board.

[Signature]  
JAMES M. KIZER, P.E. 4783

Planning Board  
June 17th 1988

North Carolina, Cumberland County  
The foregoing or annexed certificate of Margaret L. Goodwin  
Notary Public/Notaries Public is/are certified to be correct.  
This instrument was presented for registration and recorded in this Office  
at Book 2 Page 195-198  
This 17 day of June 1988 at 2:30 O'clock P  
By George E. Tatum Deputy Register of Deeds

NOTE:  
13 foot setback from right-of-way of  
Metromedical Drive was approved by  
Fay. BOA on 4-20-88.

18301  
See Declaration  
recorded in Book 3224, Page 184,  
+ Book 3368, Page 205.

REVISED UNIT 6  
AT  
MEDCO CONDOMINIUMS  
PROPERTY OF  
DR. DAVID B. GILBERT  
FAYETTEVILLE, NORTH CAROLINA  
SCALE 1"=20' JUNE 1988


RECORDED PLAT REFERENCE: P.B. 50, PG. 16  
CONDO BOOK 2, PGS. 45-52



MOORMAN & KIZER, INC.  
FAYETTEVILLE, N.C.

Condo 2-195


196

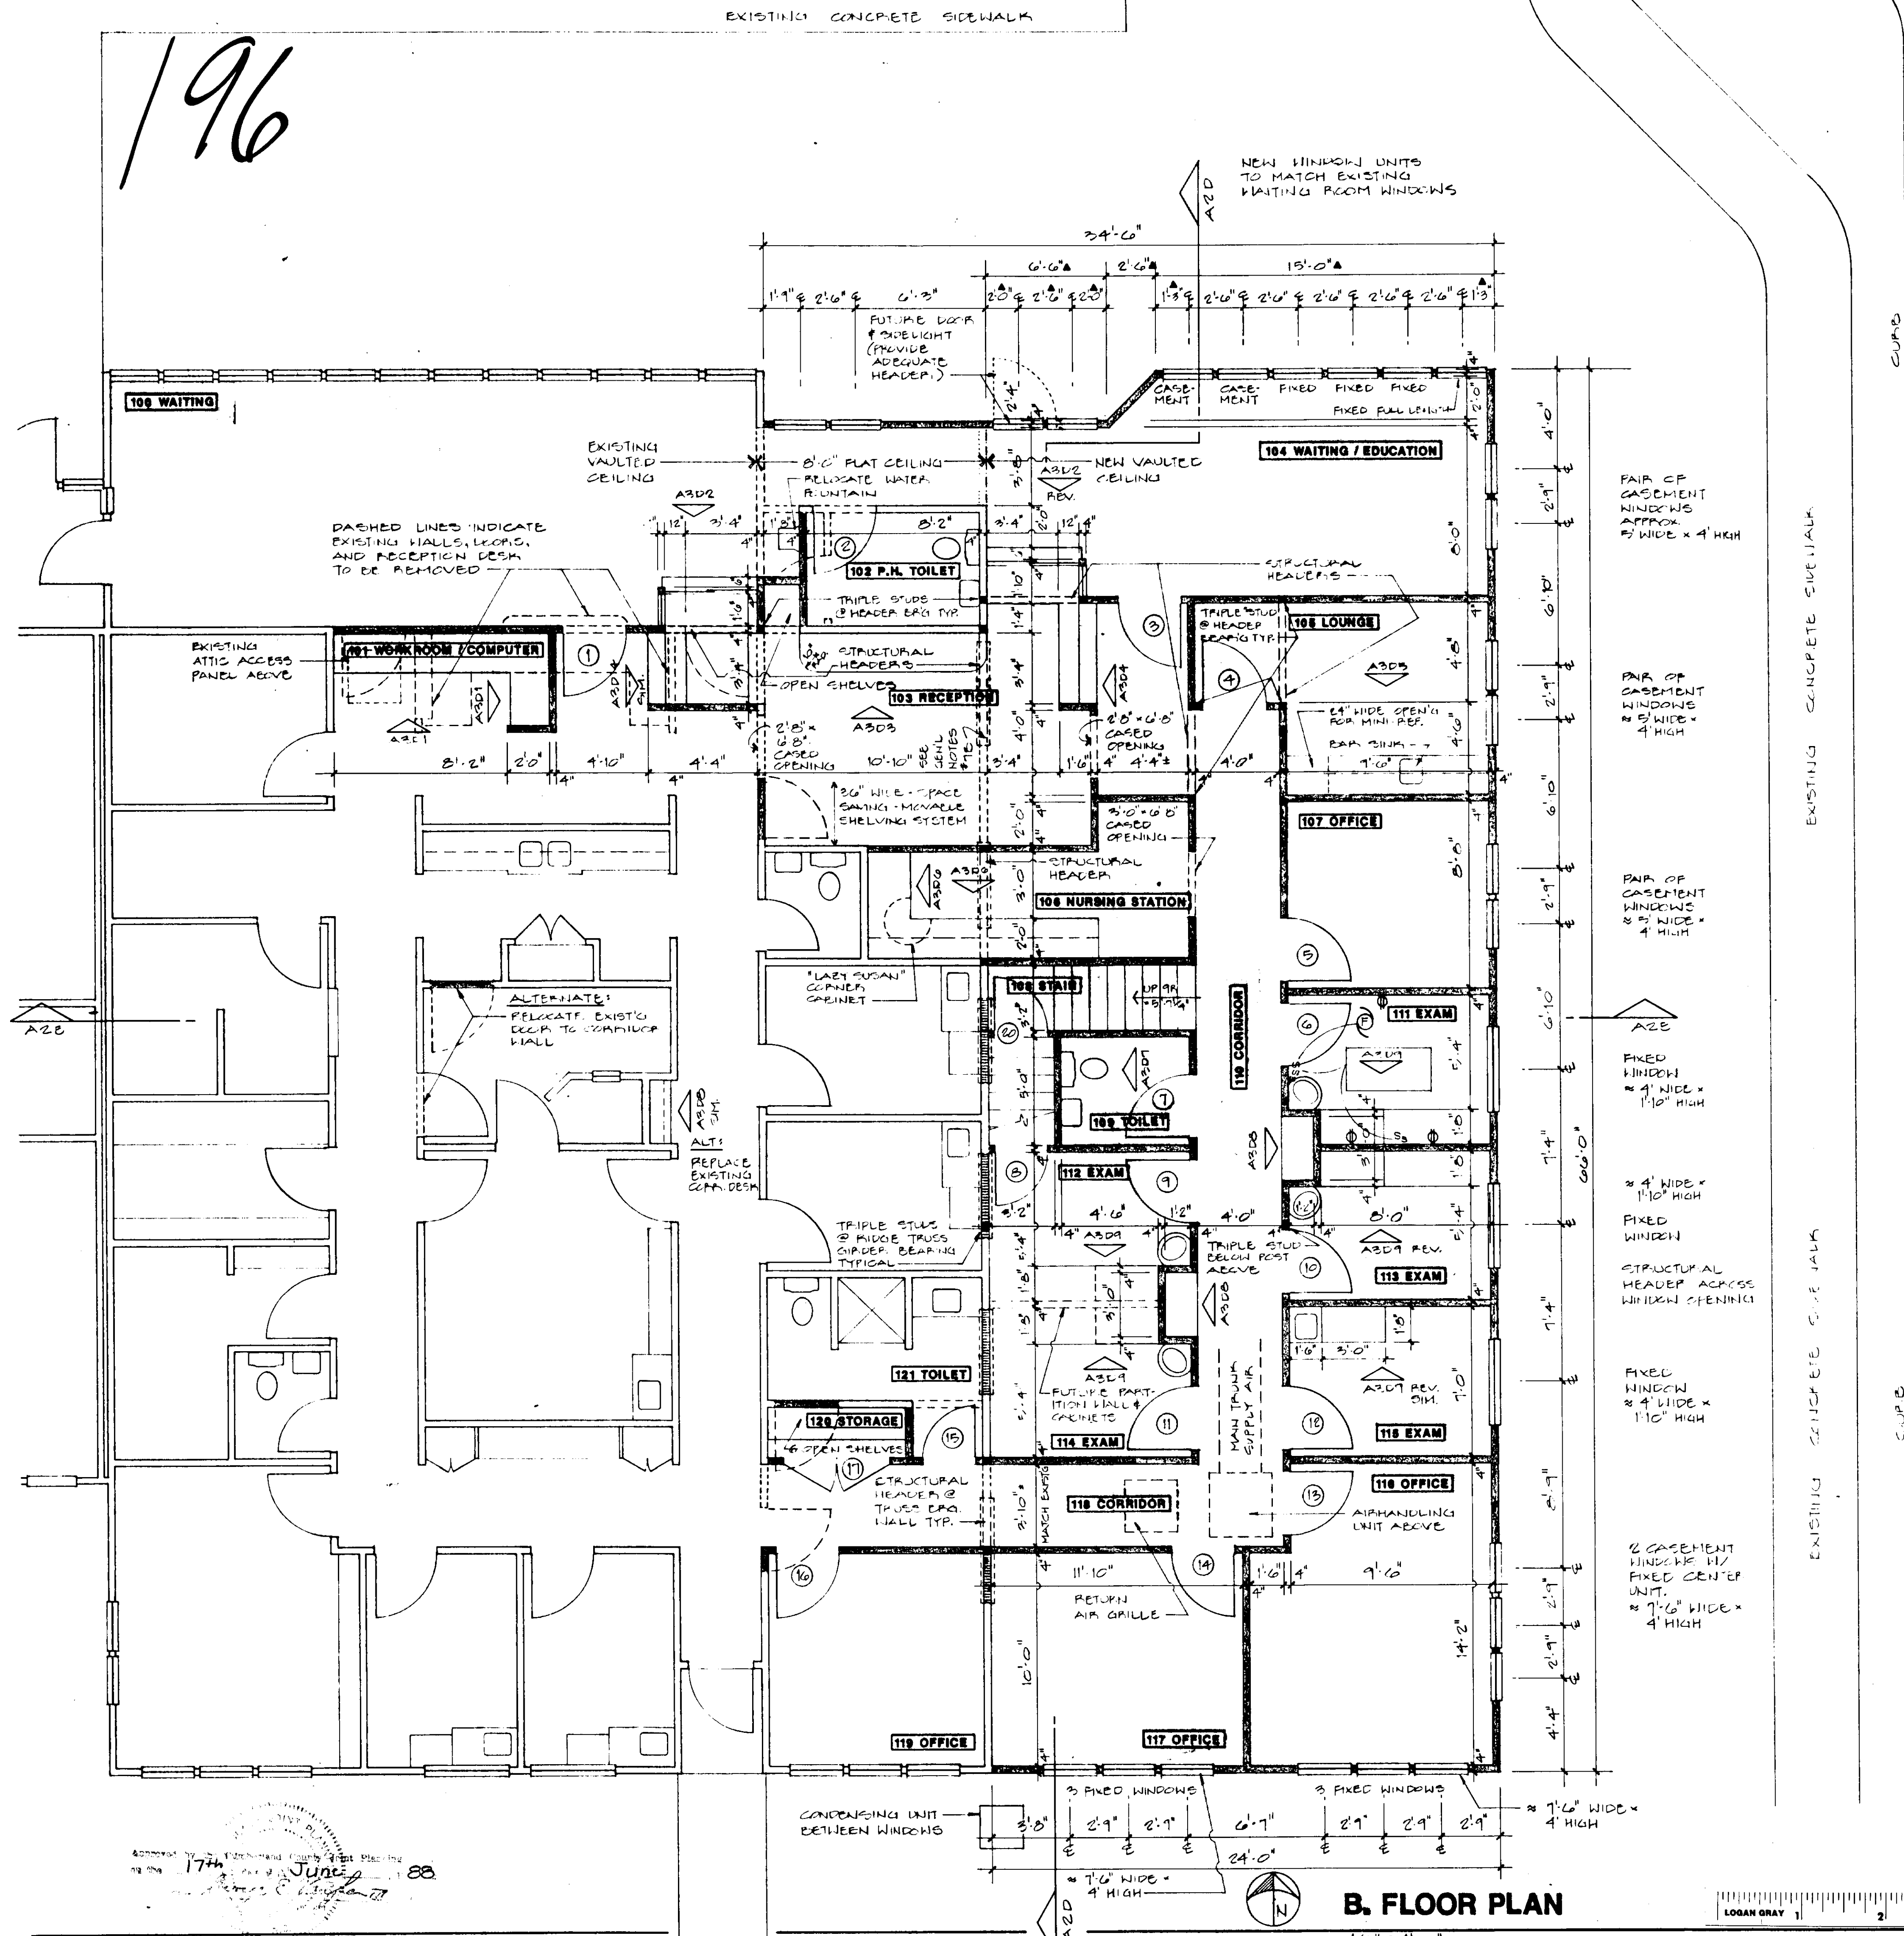


B. FLOOR PLAN

GENERAL NOTES:

- ALTERNATES:
  - REINFORCE VERTICAL AND HORIZONTAL TRUSS CHORDS ABOVE EXISTING BUILDING - REDIRECT AIRHANDLING DUCTS AS NECESSARY - PROVIDE PLYWOOD DECK FOR STORAGE (SEE A2E).
  - RELOCATE EXISTING X-RAY ROOM TO CORR. WALL (SEE A1B).
  - REPLACE EXISTING CORRIDOR DECK TO MATCH NEW DECKS IN CORR. #110.
- FINISHES:
  - VINYL WALL COVERING, VINYL FLOORING, CARPET, PLASTIC LAMINATE, AND PAINT COLORS TO BE SELECTED BY OWNER.
- MECHANICAL:
  - AIR HANDLING UNIT, MAIN TRUNK LINE & FLEX DUCT TO BE SIZED BY CONTRACTOR (INDEPENDENT SYSTEM FROM EXISTG).
  - PROVIDE EXHAUST FANS, SEPARATELY SWITCHED, FOR ROOMS #107, 111, 112, 113, 114, & 115.
- ELECTRICAL:
  - PROVIDE NEW DISTIB. PANEL FOR ALUTION AS SUB. PANEL TO EXISTG - WITH LEAD TO ALLOW SEPARATE FUTURE METER/SERVICE.
  - LAYOUT OF DUPLEX OUTLETS, LIGHTING, ETC. TO BE SIMILAR TO EXISTING AND SUBJECT TO OWNER VERIFICATION. EXAMPLE EXAM RM. LAYOUT SHOWN IN RM #111.
- WINDOWS:
  - NORTH FACING (#104 WAITING/EDUCATION) WINDOWS SHOULD MATCH EXISTING IN RM #100 WAITING.
  - ALL OTHER NEW UNITS TO BE LOW "E" GLASS - SOUTH, EAST, & UPPER FLOOR.
- SPECIAL EQUIPMENT:
  - X-RAY VIEW BOXES FOR CORR. DESKS TO BE BY OWNER.
  - 36" WIDE, TRACK MOUNTED, MOVABLE SHELVING SYSTEM TO BE PROVIDED IN #103 RECEPTION FOR FILE STORAGE - BY OWNER.
- STRUCTURAL:
  - TRUSS MANUF. TO SIZE RIDGE TRUSS GIRDER.
  - STRUCTURAL HEADER @ 103 RECEPTION (10' SPAN) TO BE EITHER W12x14 STEEL BEAM OR 2-134"x14" MICRO-LAM W.D.M. - OPEN TO WAITING/EDUCATION.

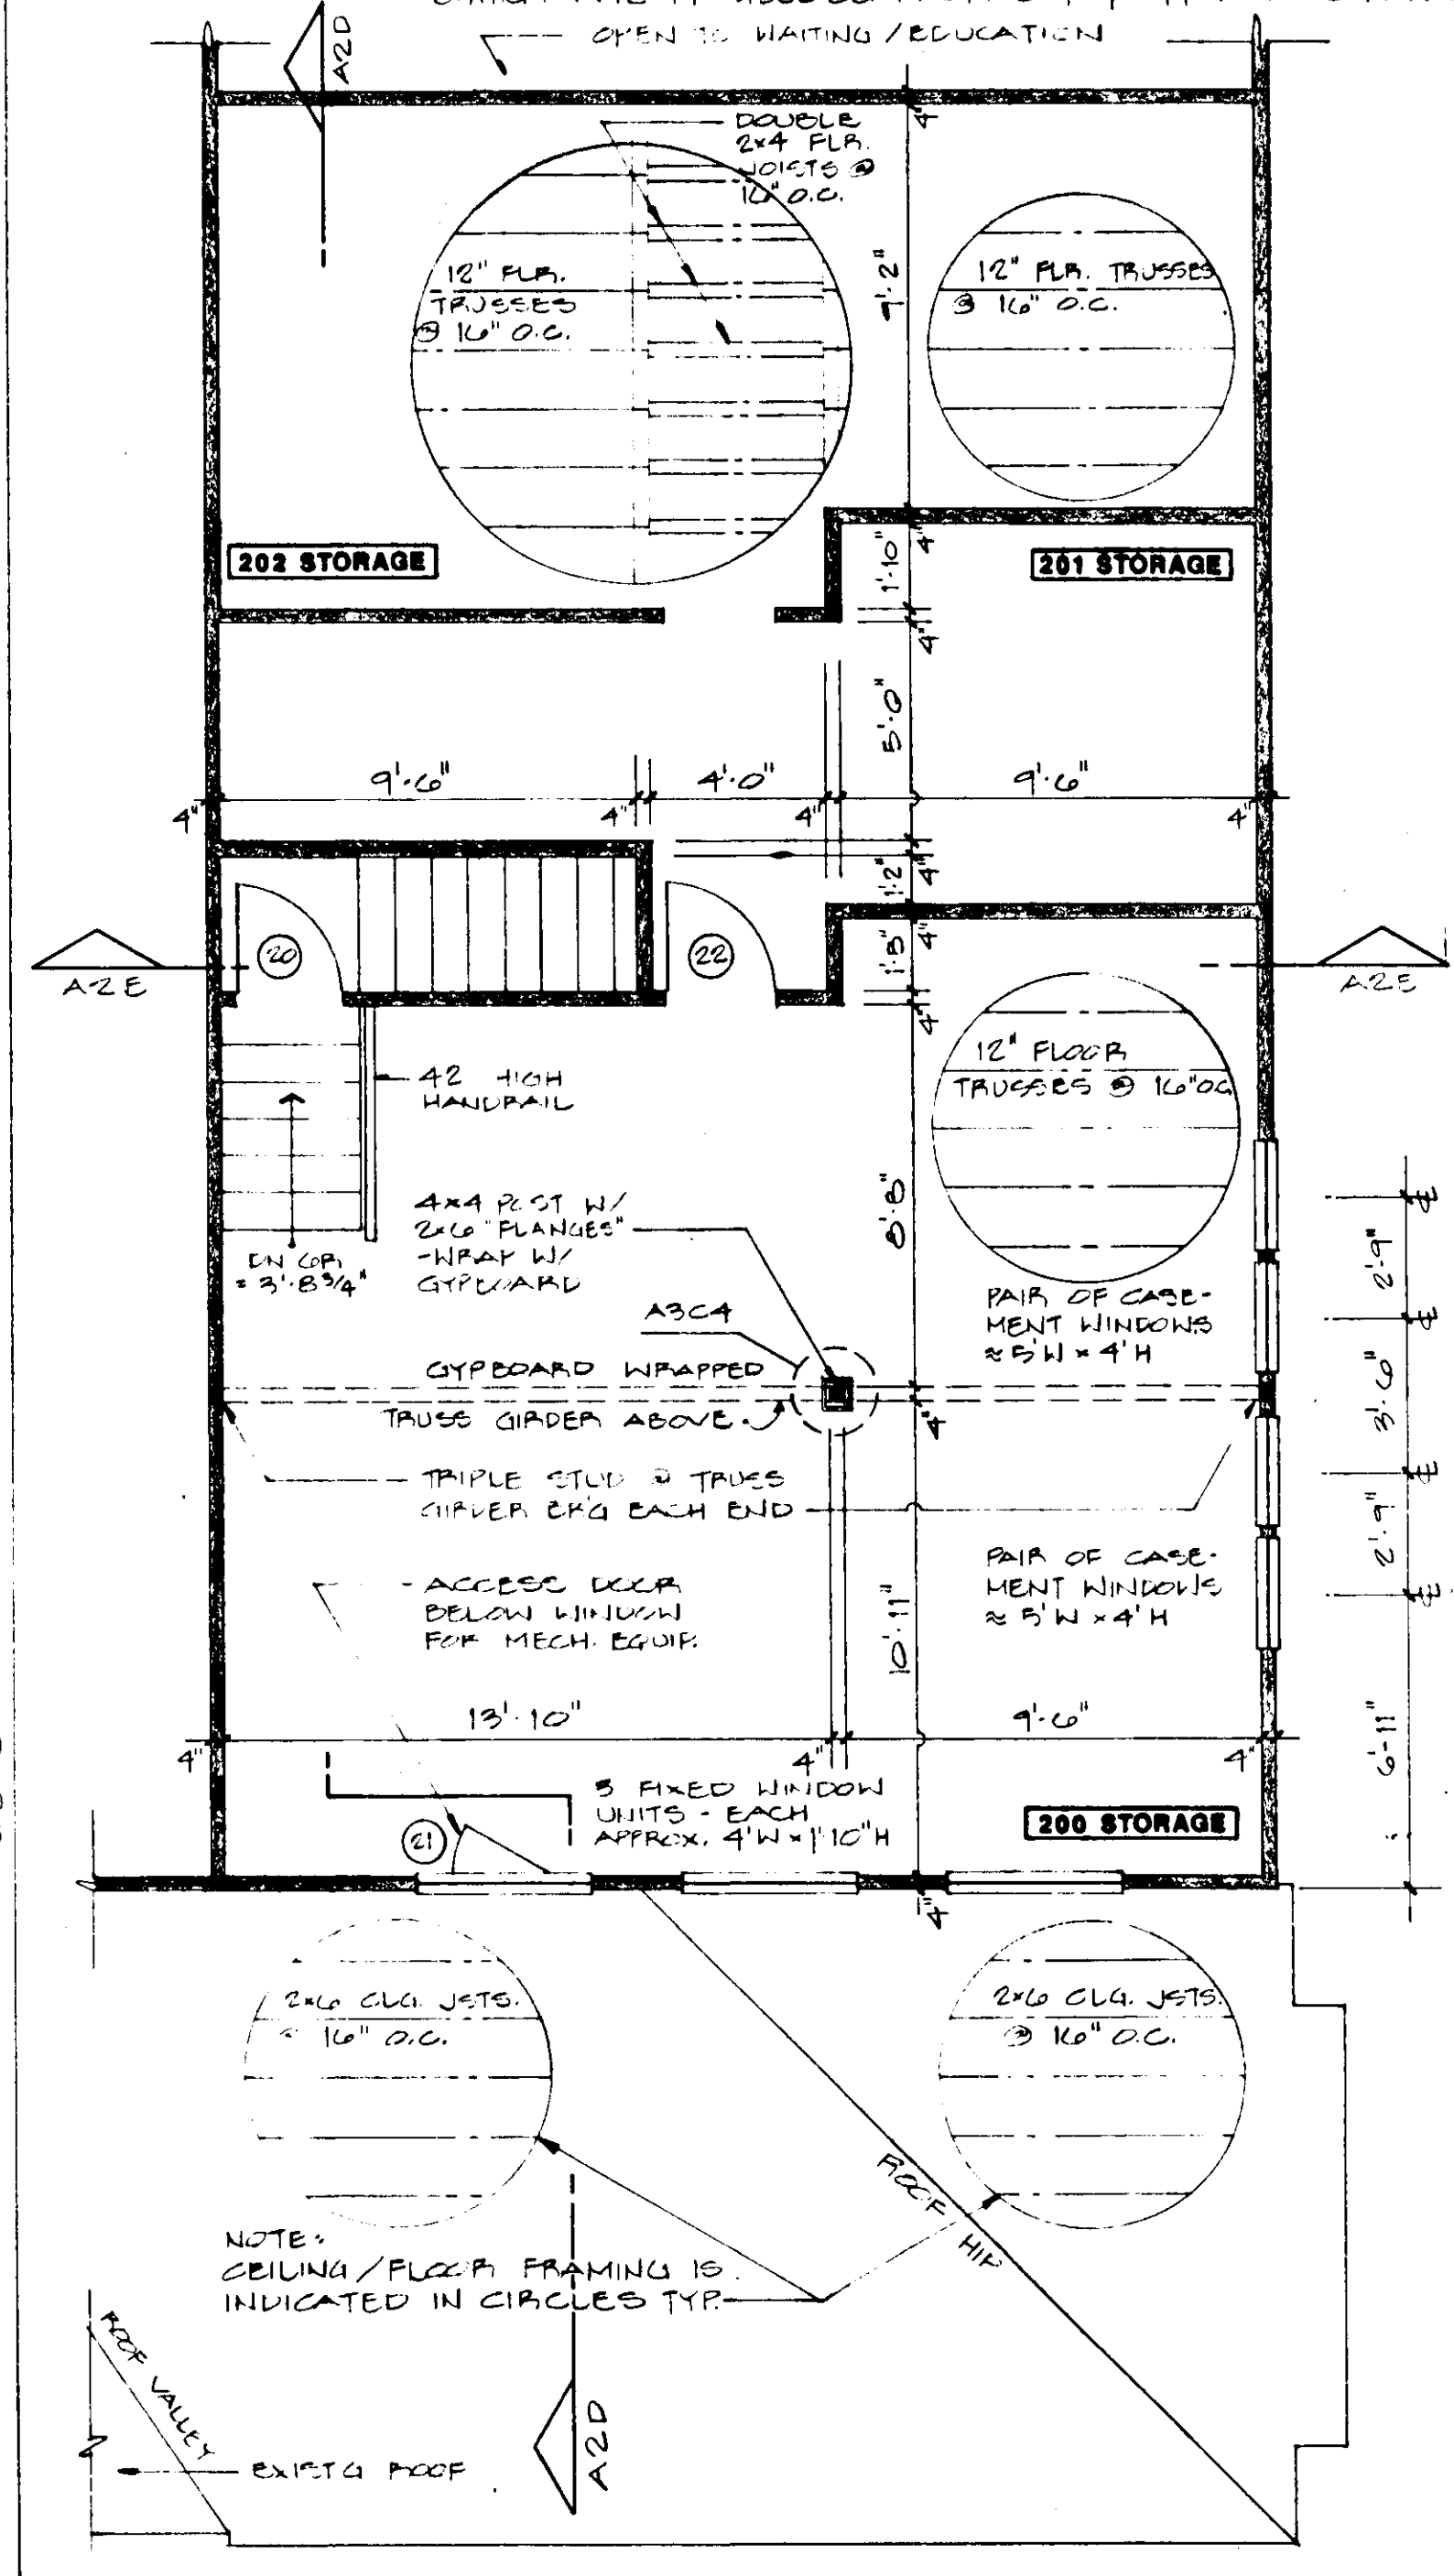

A. STORAGE FLOOR PLAN

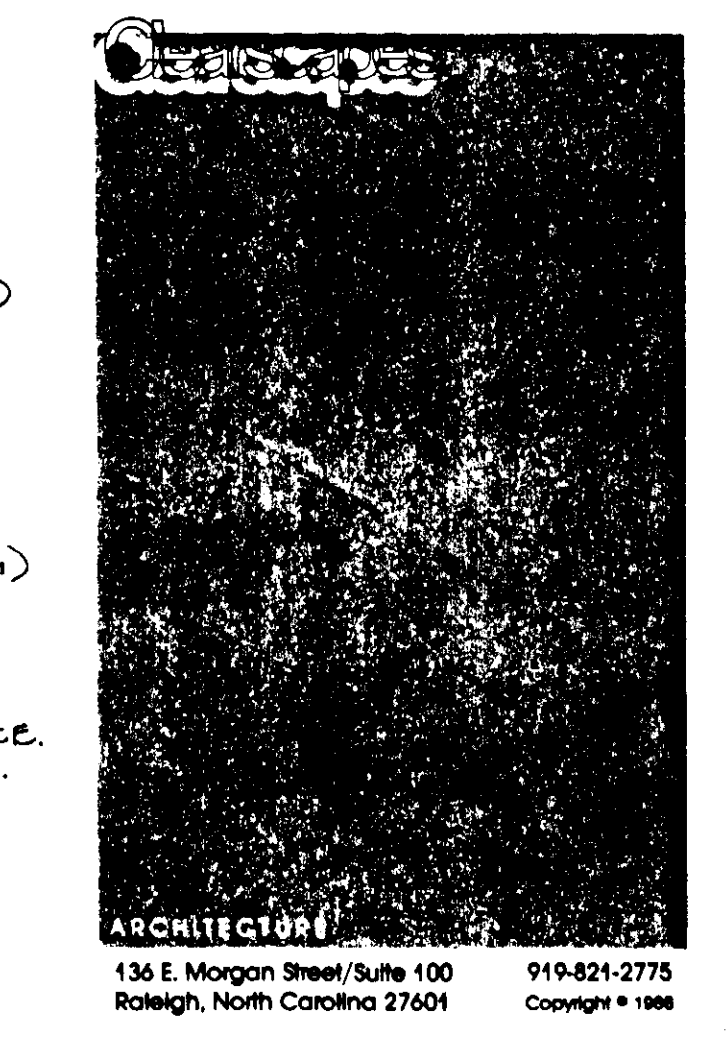

- KEY:
- EXISTING WALLS TO BE REMOVED
  - EXISTING WALLS TO REMAIN
  - NEW CONSTRUCTION
  - INFILL @ EXISTG. WINDOWS

ADDITION TO THE OFFICES OF:  
**DAVID B. GILBERT, M.D.**  
 &  
**D. WAYNE WHETSELL, M.D.**  
 1756 METROMEDICAL DRIVE  
 FAYETTEVILLE,  
 NORTH CAROLINA




Approved by: [Signature] 17th June 88

NO DUCT FOR 10 JUN 88 10 36 87  
 A1  
 Combo-196


DOOR SCHEDULE					FINISH SCHEDULE							
DOOR SIZE	DOOR DESCRIPTION	TYPE	FRAME	REMARKS	MARK	ROOM NAME	FLOOR	BASE	WALL	CEILING	REMARKS	
1	3'-0" x 6'-0" = 1 3/4"	WOOD / SOLID CORE / GLASS	1	WOOD		100	WAITING (EXISTING)	EXIST'G	EXIST'G	GYP. BD.	EXIST'G	COVER NEW GYP. TO MATCH EXISTING
2		/ FLUSH	2			101	WORKROOM / COMPUTER	CARPET	WOOD		EXIST'G	
3		/ GLASS	1			102	P.H. TOILET	VINYL	RUBBER		GYP. BD.	
4		/ GLASS	1			103	RECEPTION	CARPET	FLASHING			
5		/ FLUSH	2			104	WAITING / EDUCATION	WOOD				
6						105	LOUNGE		FLASHING			
7						106	NURSING STATION					
8	2'-6"					107	OFFICE					FINISHES SPECIFIED BY OWNER
9	3'-0"					108	STAIR					
10						109	TOILET	VINYL	RUBBER			
11						110	CORRIDOR	CARPET	WOOD			
12						111	EXAM		FLASHING			
13						112	EXAM					
14						113	EXAM					
15	2'-6"					114	EXAM					
16	3'-0"					115	EXAM					
17	PR. 2'-6"					116	OFFICE					FINISHES SPECIFIED BY OWNER
						117	OFFICE					
20	2'-6" x 6'-0" = 1 3/4"	WOOD / SOLID CORE / GLASS	1	WOOD		118	CORRIDOR		WOOD			
21	2'-4" x 2'-6"	/ FLUSH	2			119	OFFICE		FLASHING			FINISHES SPECIFIED BY OWNER
22	2'-6" x 5'-10"					120	STORAGE		RUBBER			
						121	TOILET	VINYL				
						200	STORAGE	CARPET	RUBBER	GYP. BD.	GYP. EW.	
						201	STORAGE	PLUMB				LEAVE GYP. BOARD UNPAINTED
						202	STORAGE					

NOTES: MATCH EXISTING FINISHES IN LIFE NEW ROOMS (IC: NEW EXAM RM. FINISHES MATCH EXIST'G EXAM RMs)


E. SCHEDULES

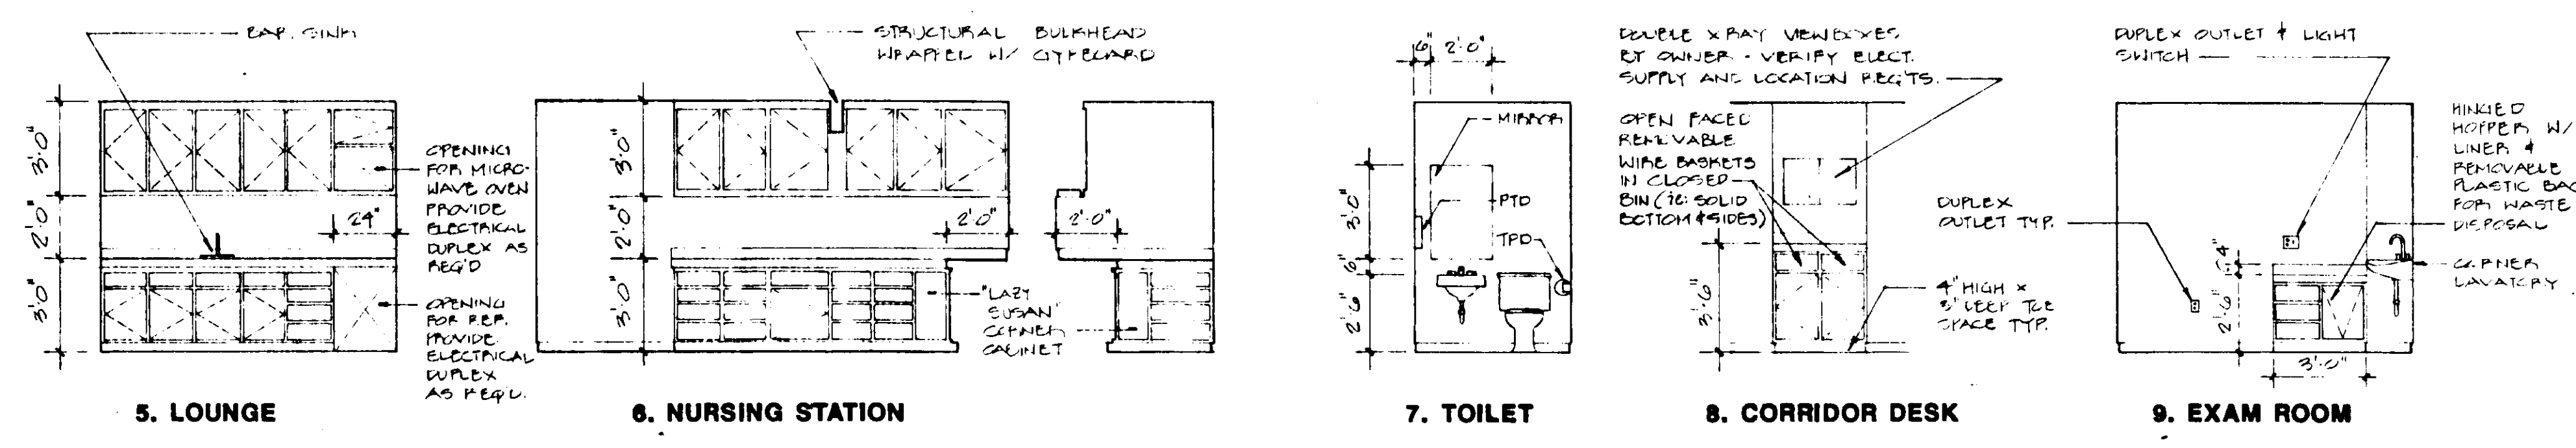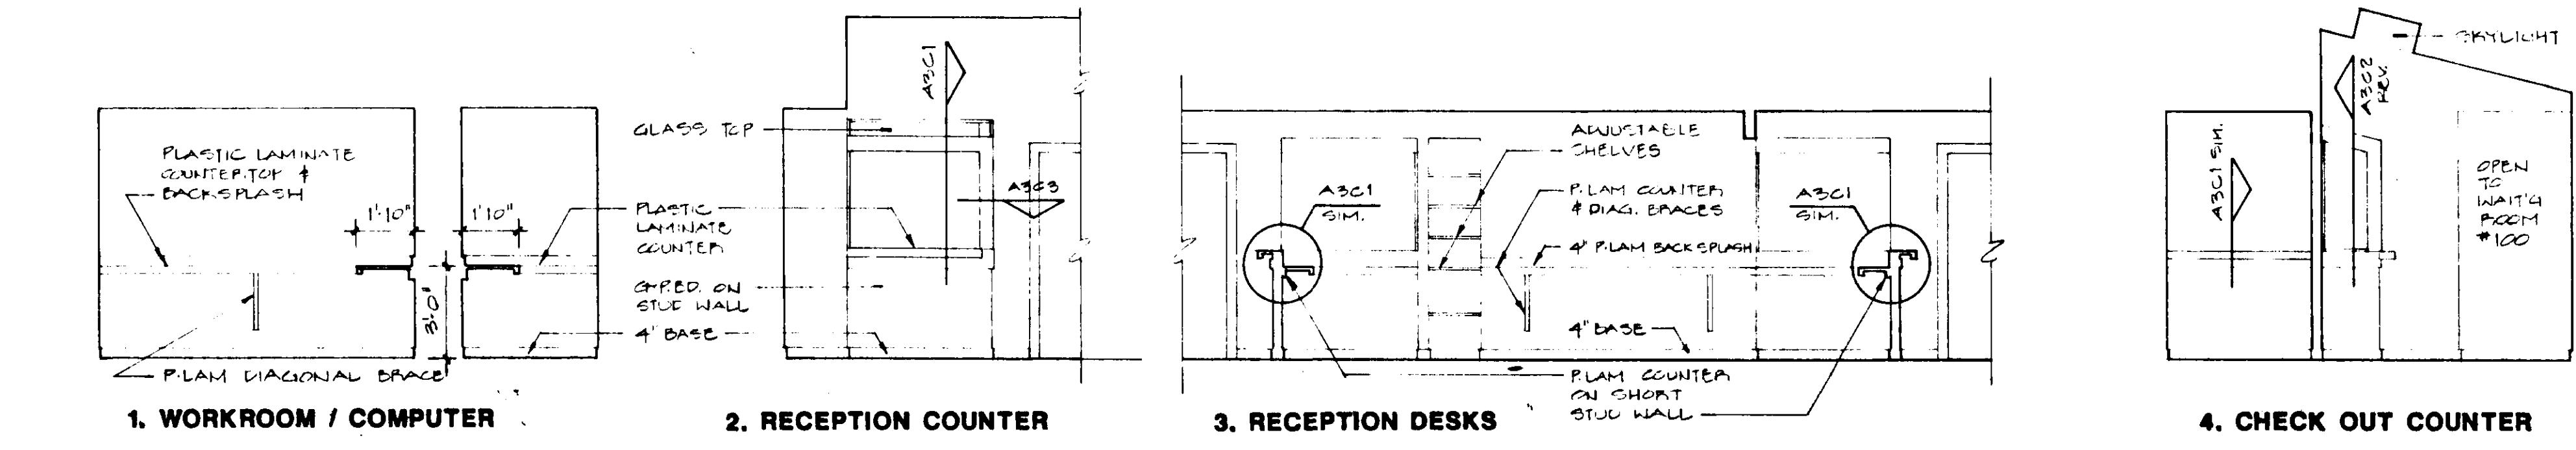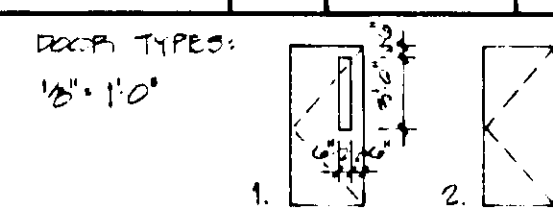


D. INTERIOR ELEVATIONS

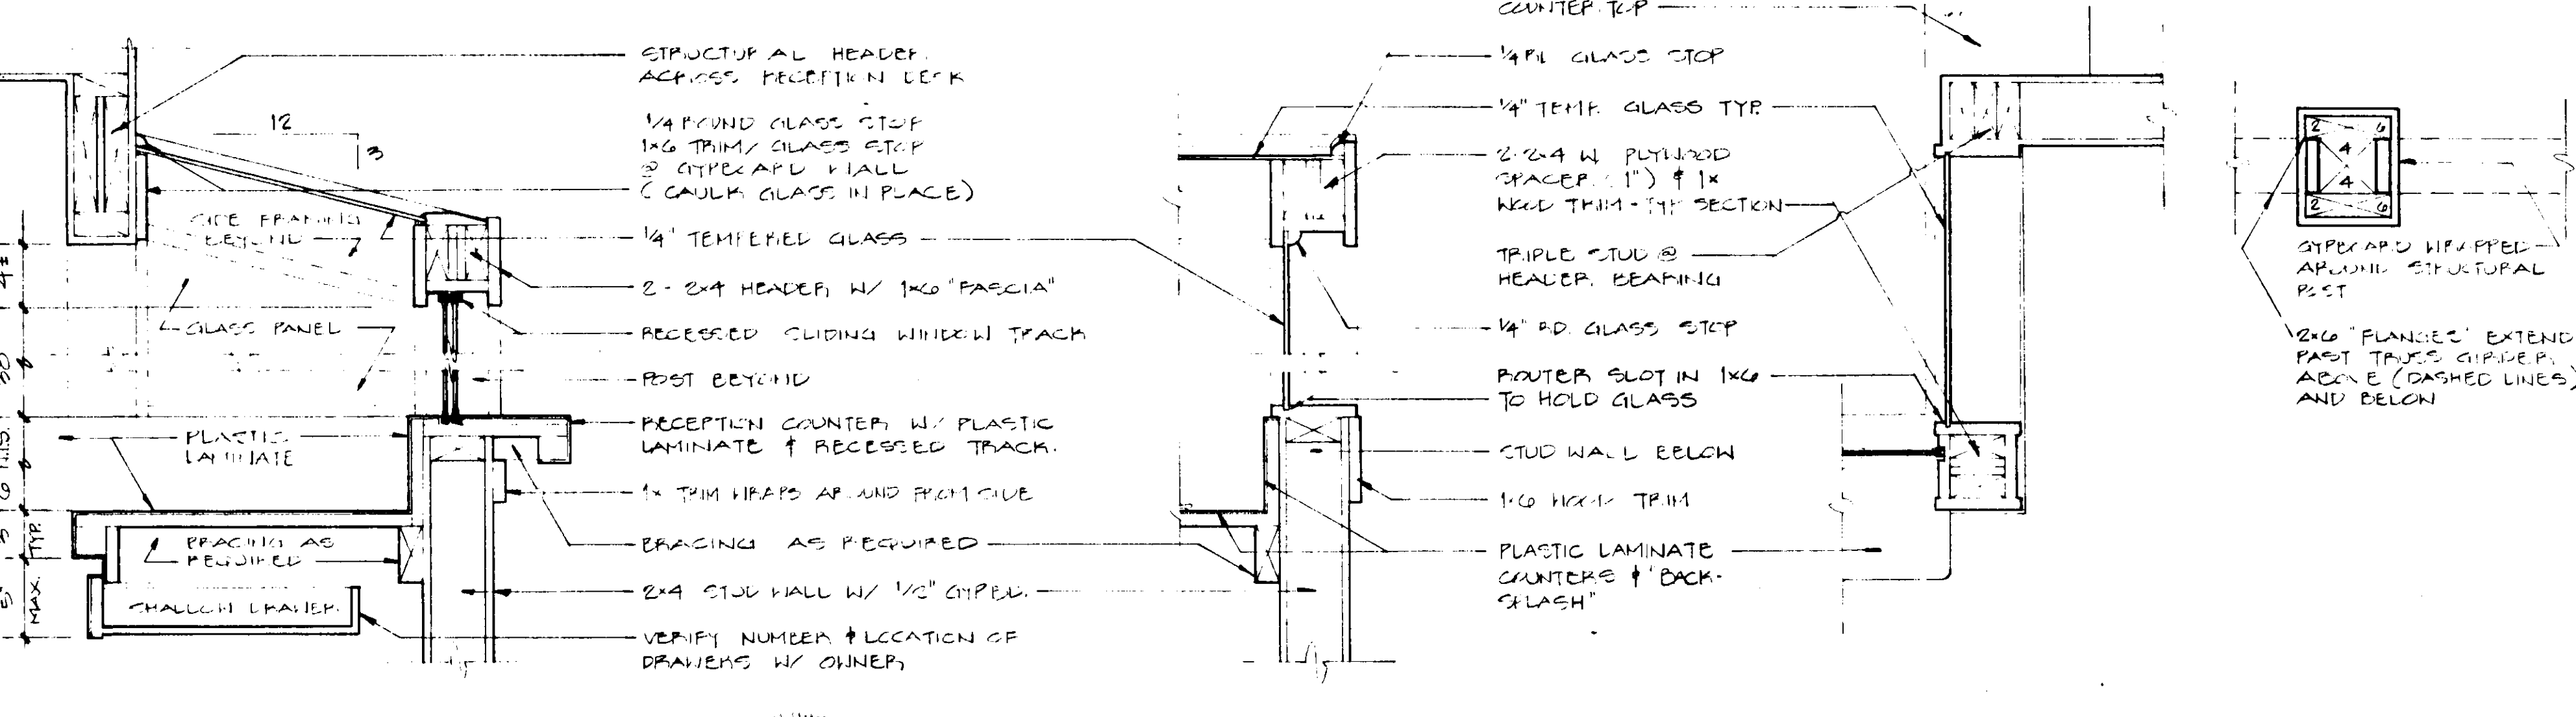

C. DETAILS

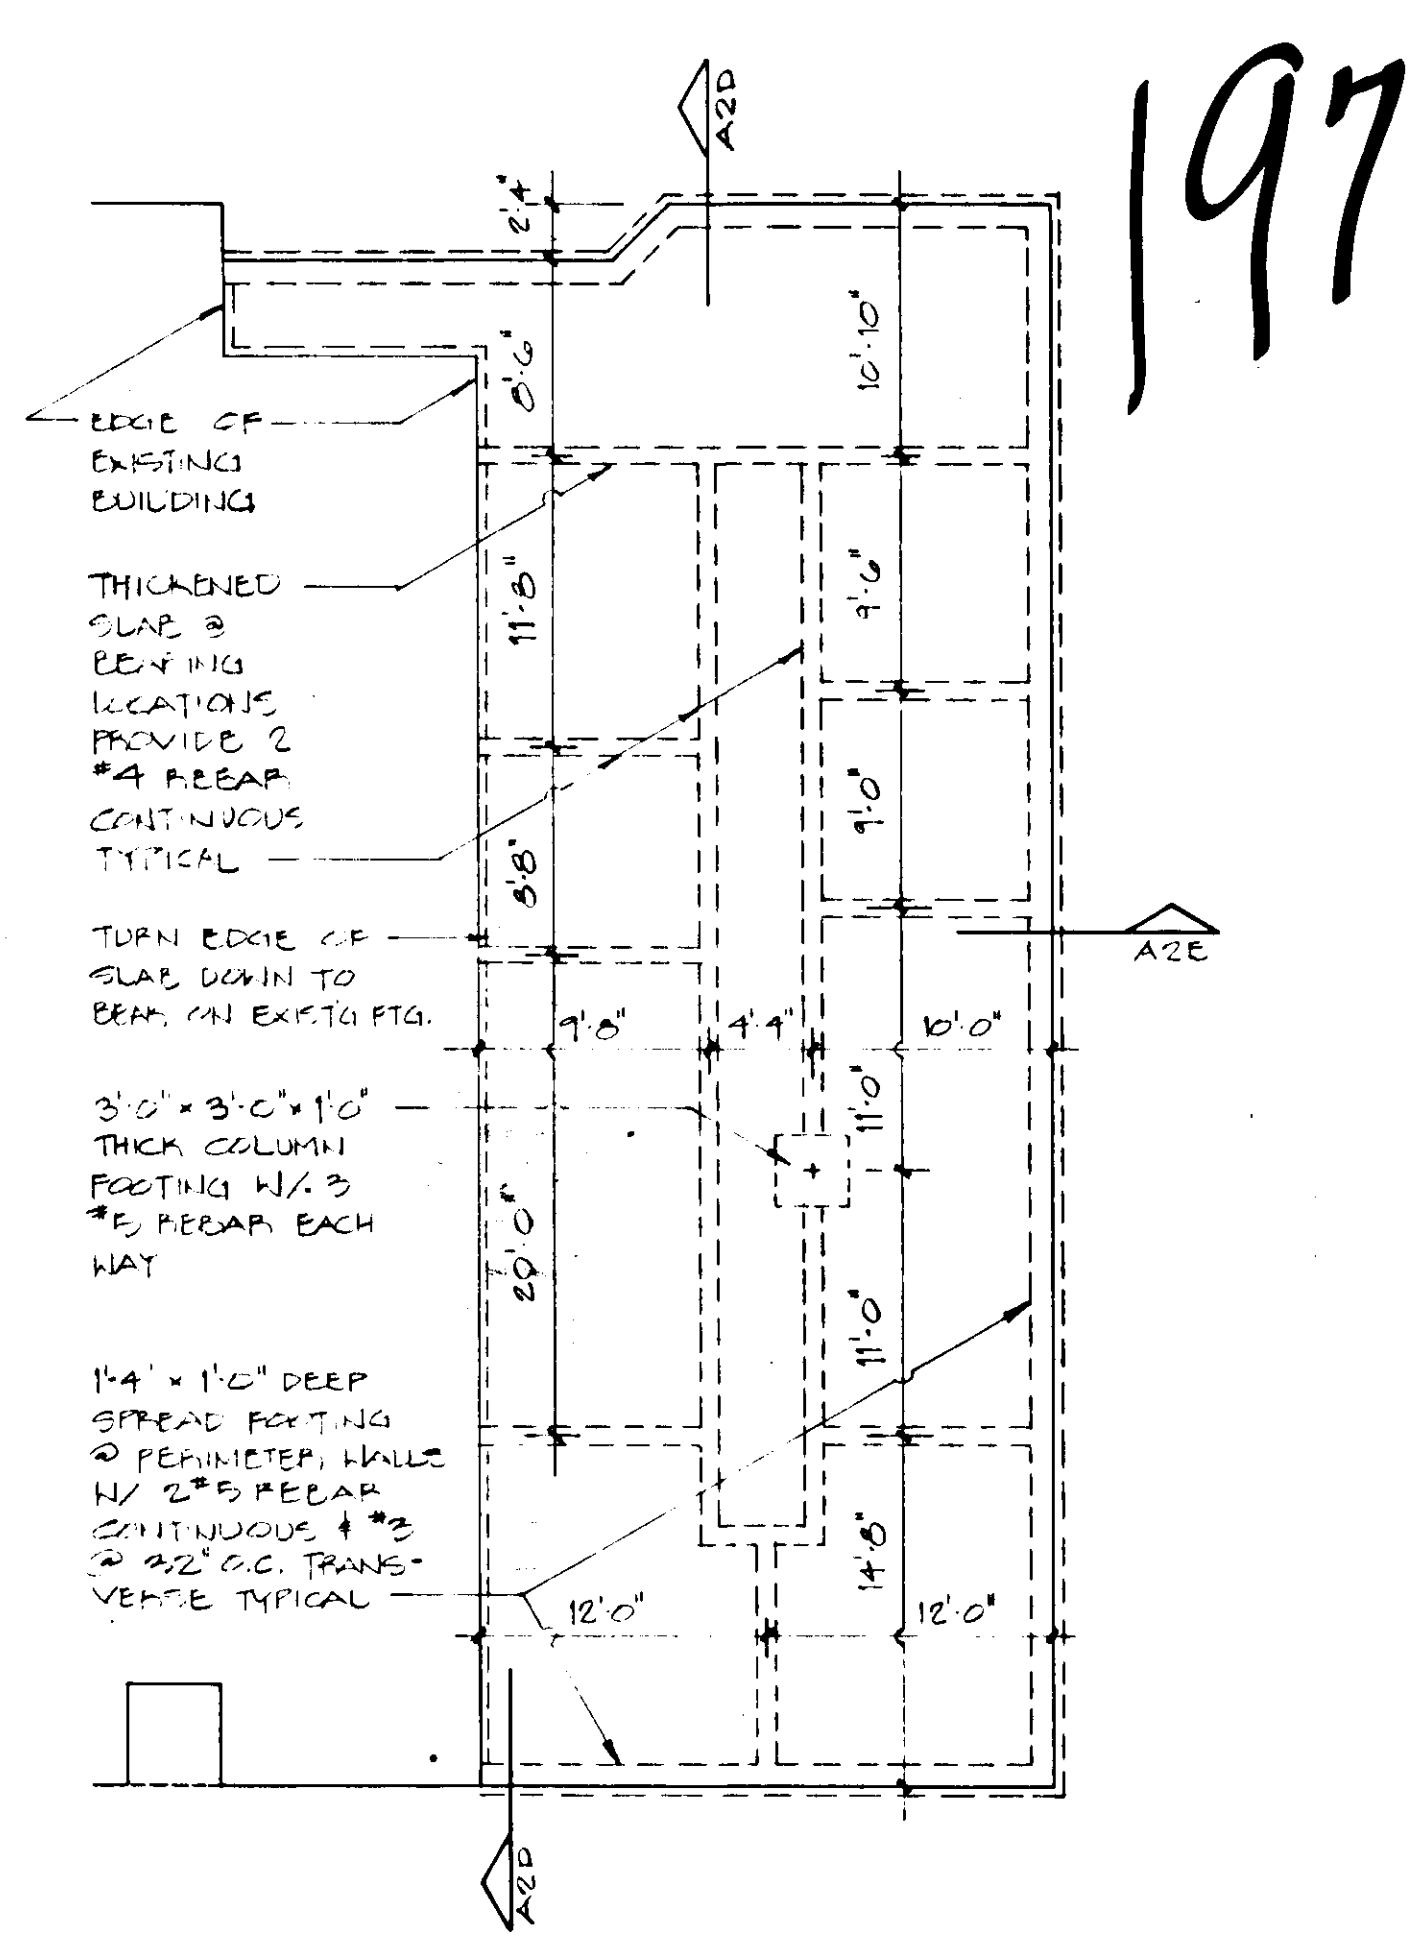

B. FOUNDATION PLAN

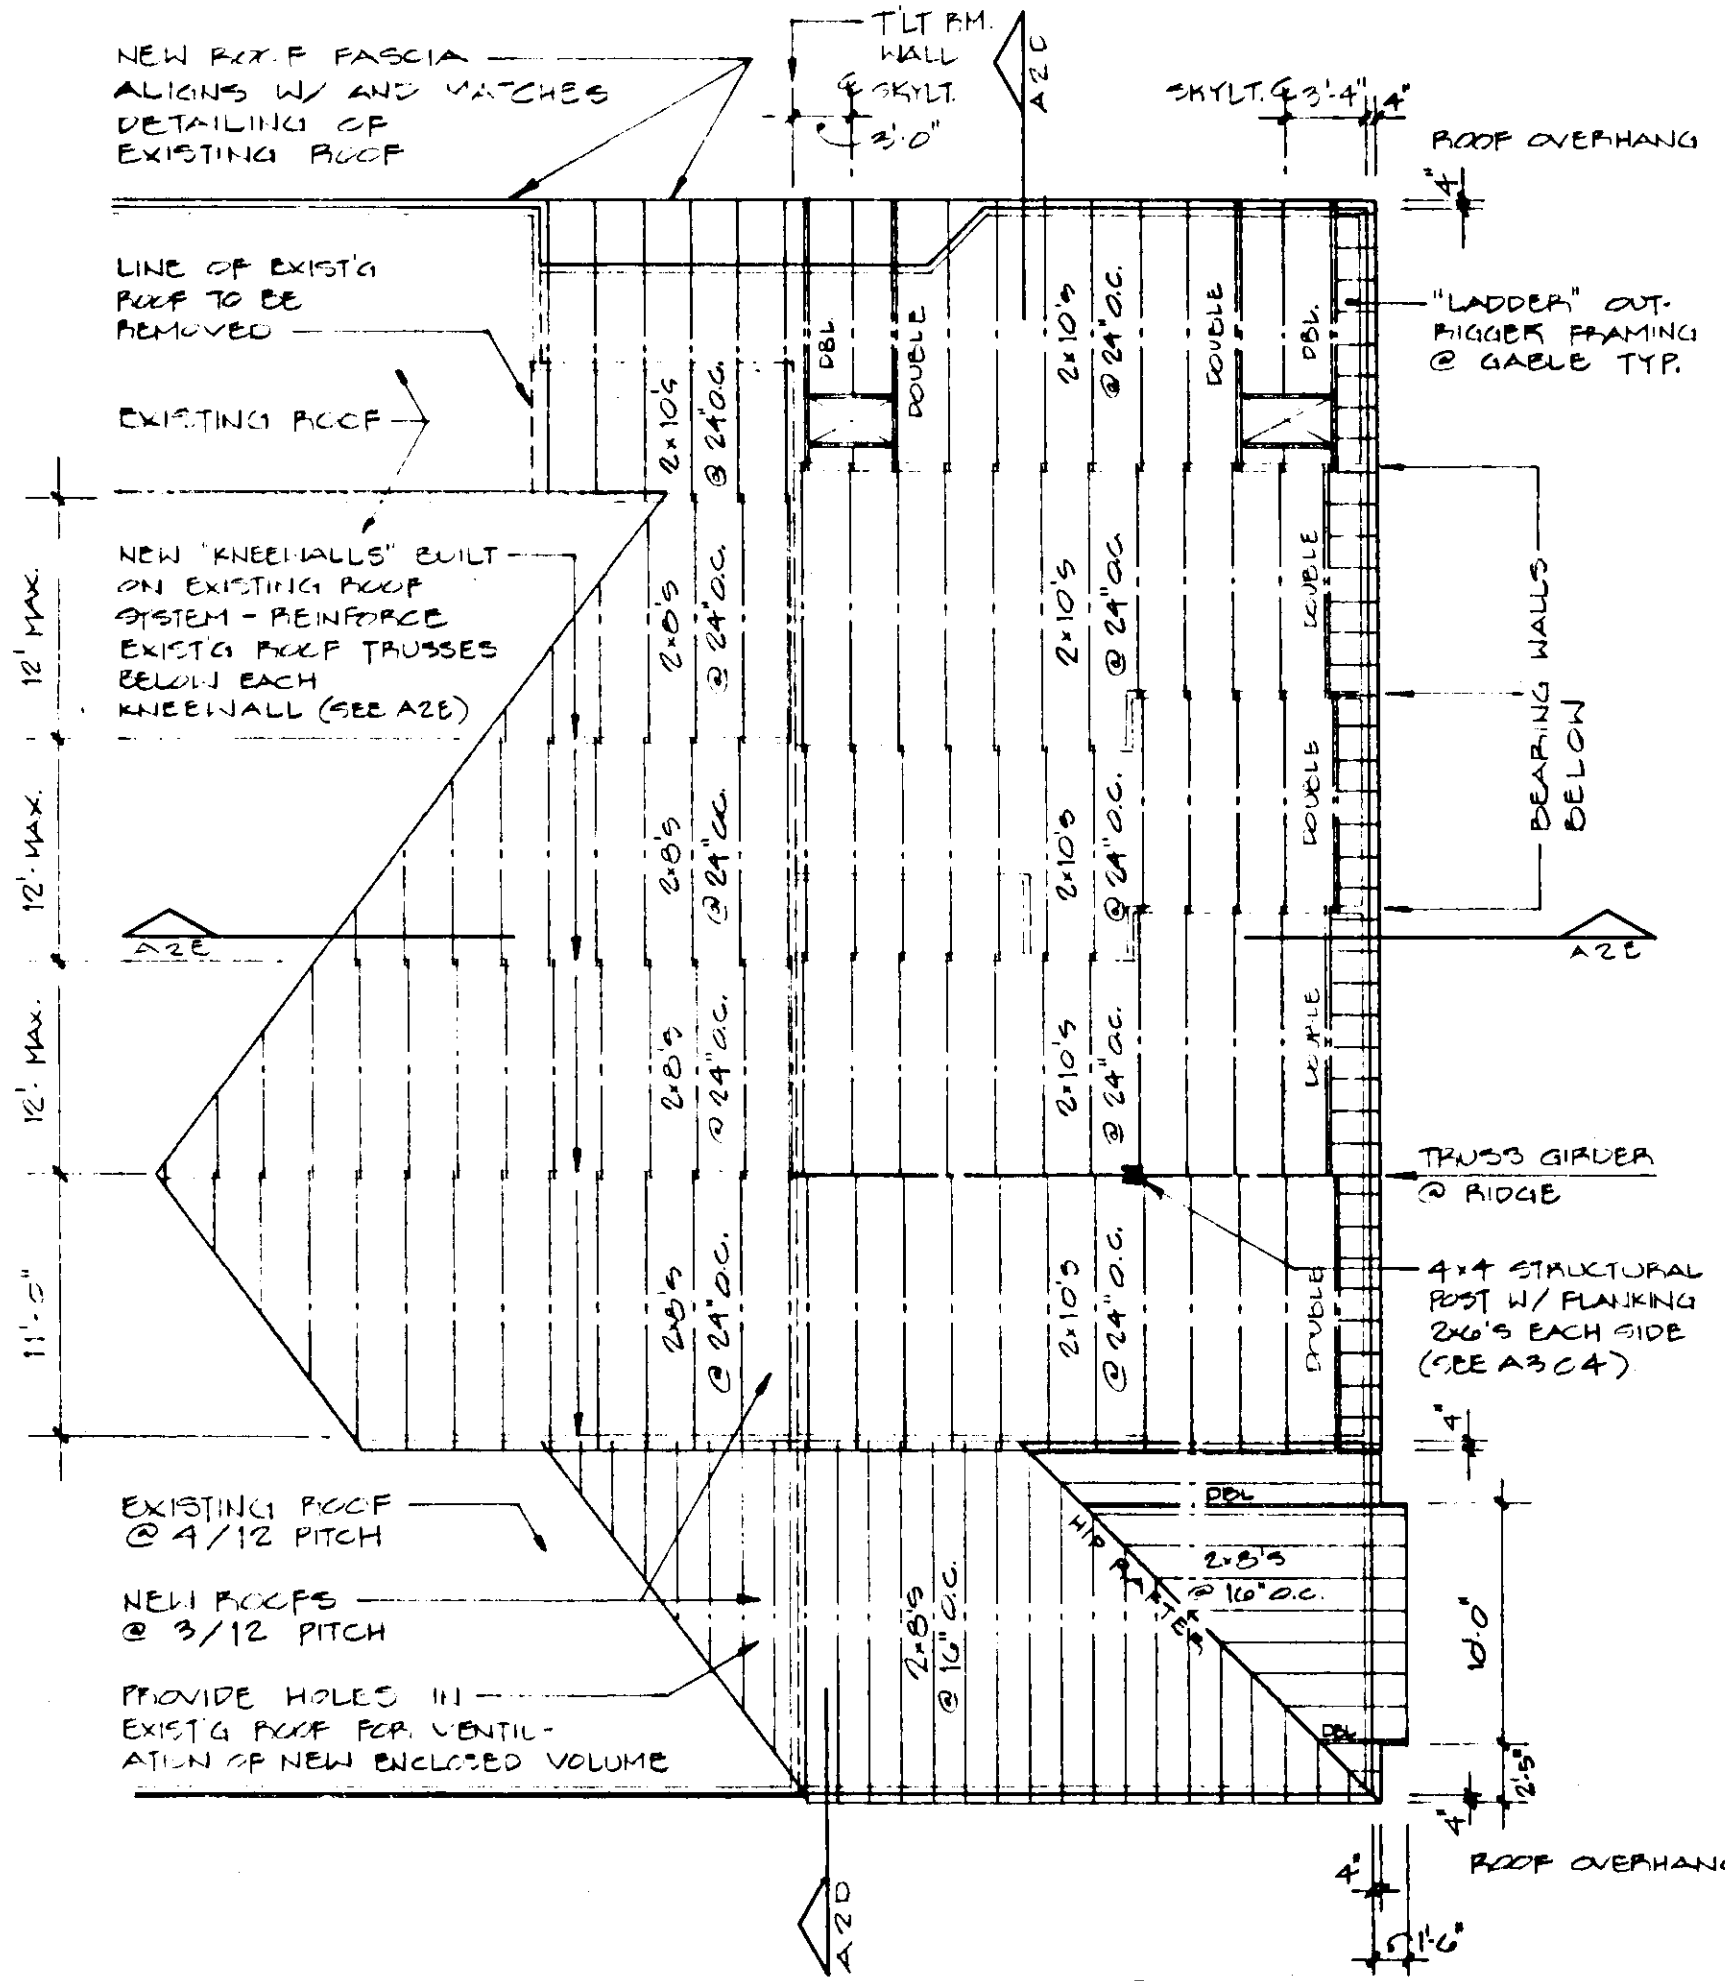

A. ROOF FRAMING PLAN


**Crump**  
 ARCHITECTS  
 136 E. Morgan Street/Suite 100  
 Raleigh, North Carolina 27601  
 919-821-2775  
 Copyright © 1998

197


ADDITION TO THE  
 OFFICES OF:  
**DAVID B. GILBERT, M.D.**  
 &  
**D. WAYNE WHITSELL, M.D.**  
 1756 METROMEDICAL DRIVE  
 FAYETTEVILLE,  
 NORTH CAROLINA

**A3**  
 Condo 2-197


198

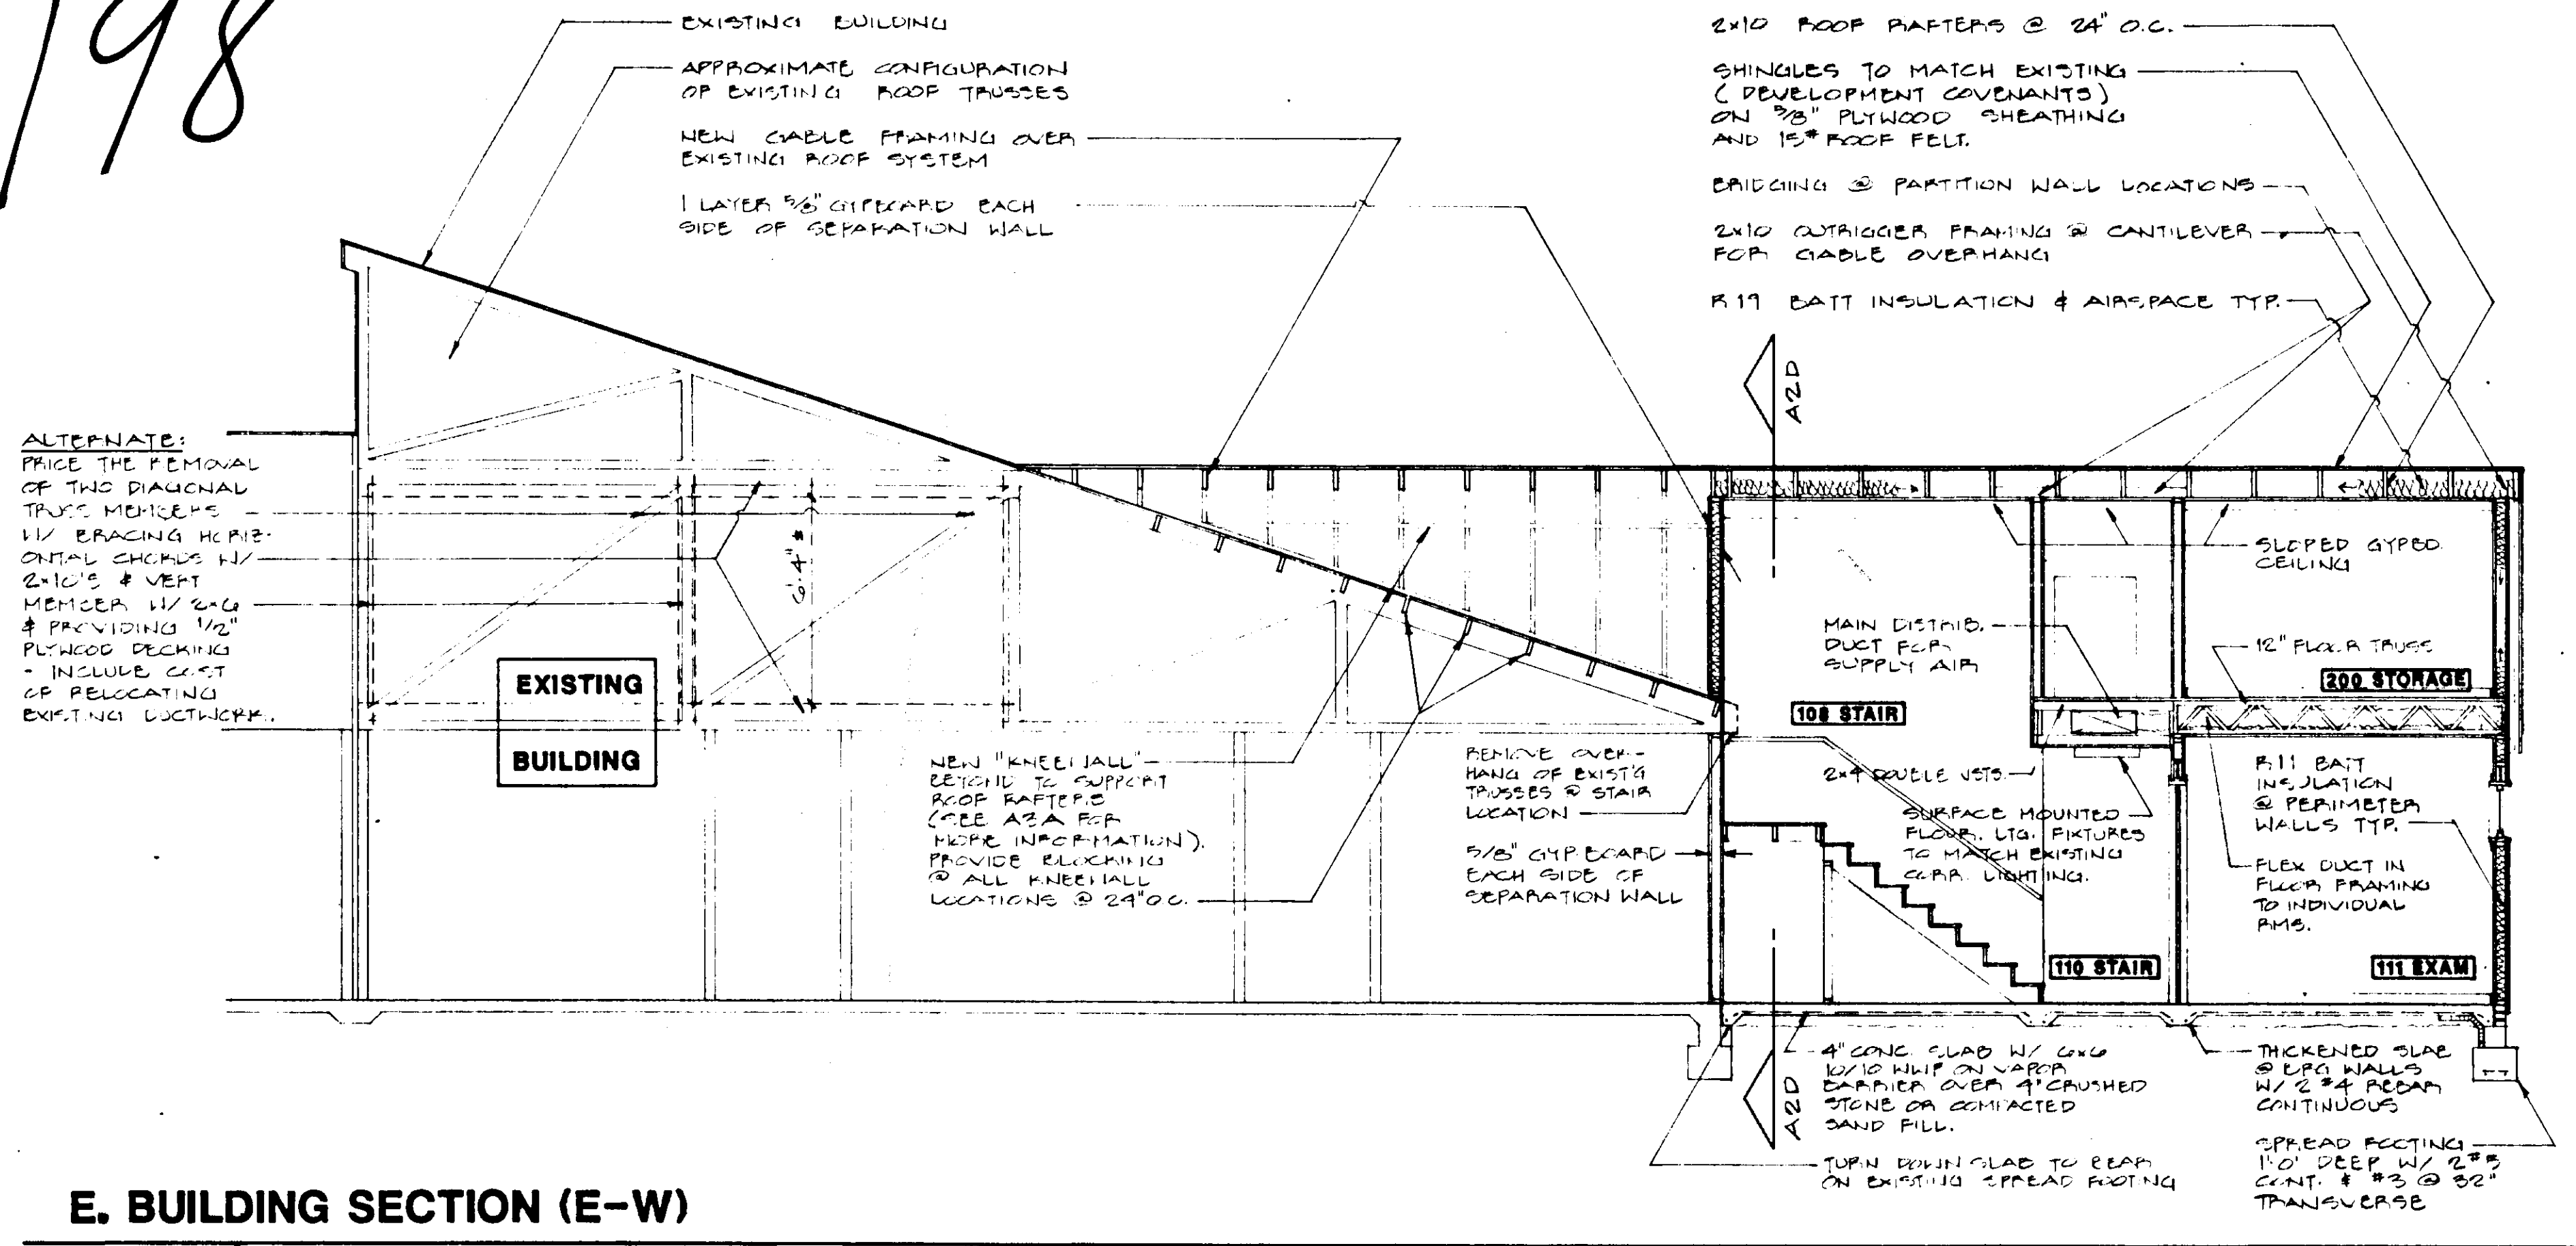


**E. BUILDING SECTION (E-W)**

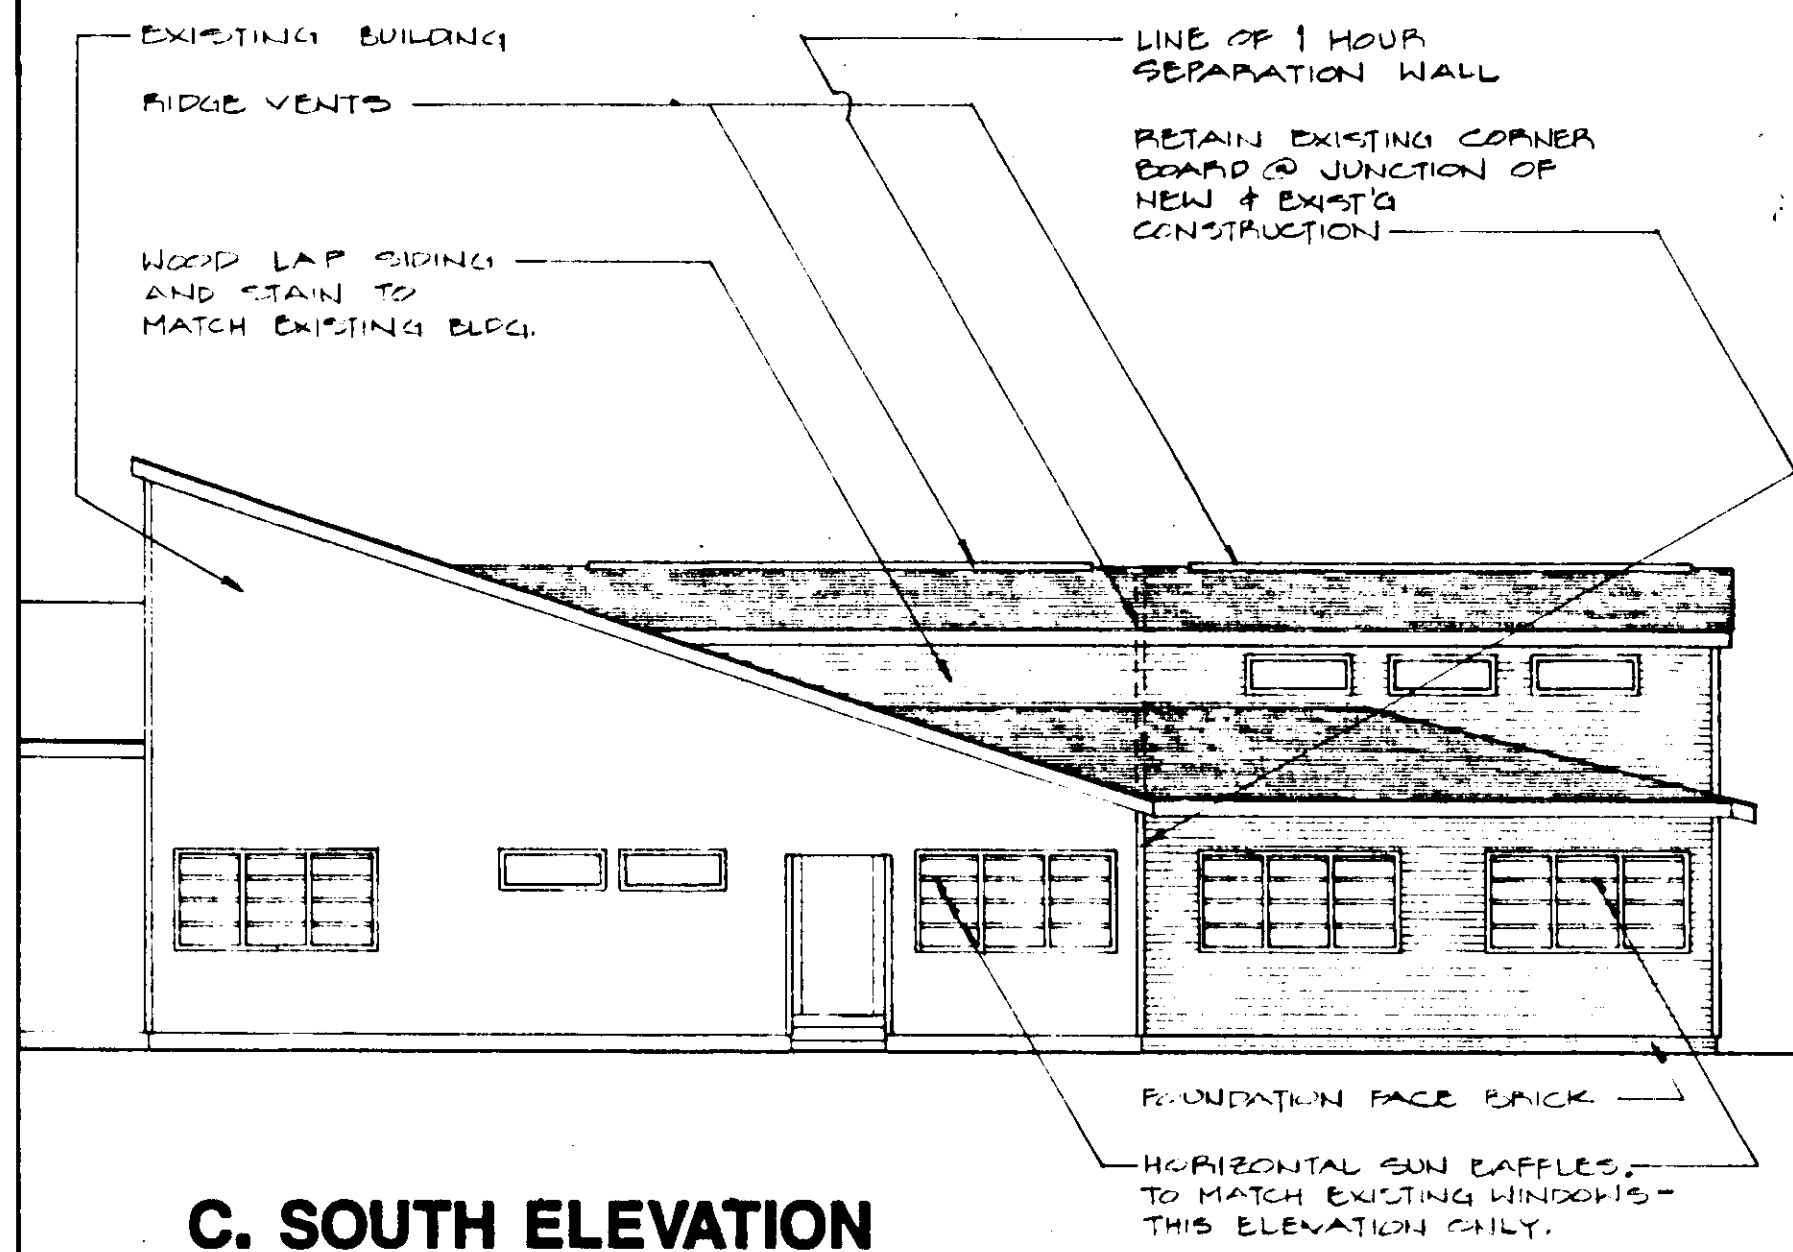


**C. SOUTH ELEVATION**

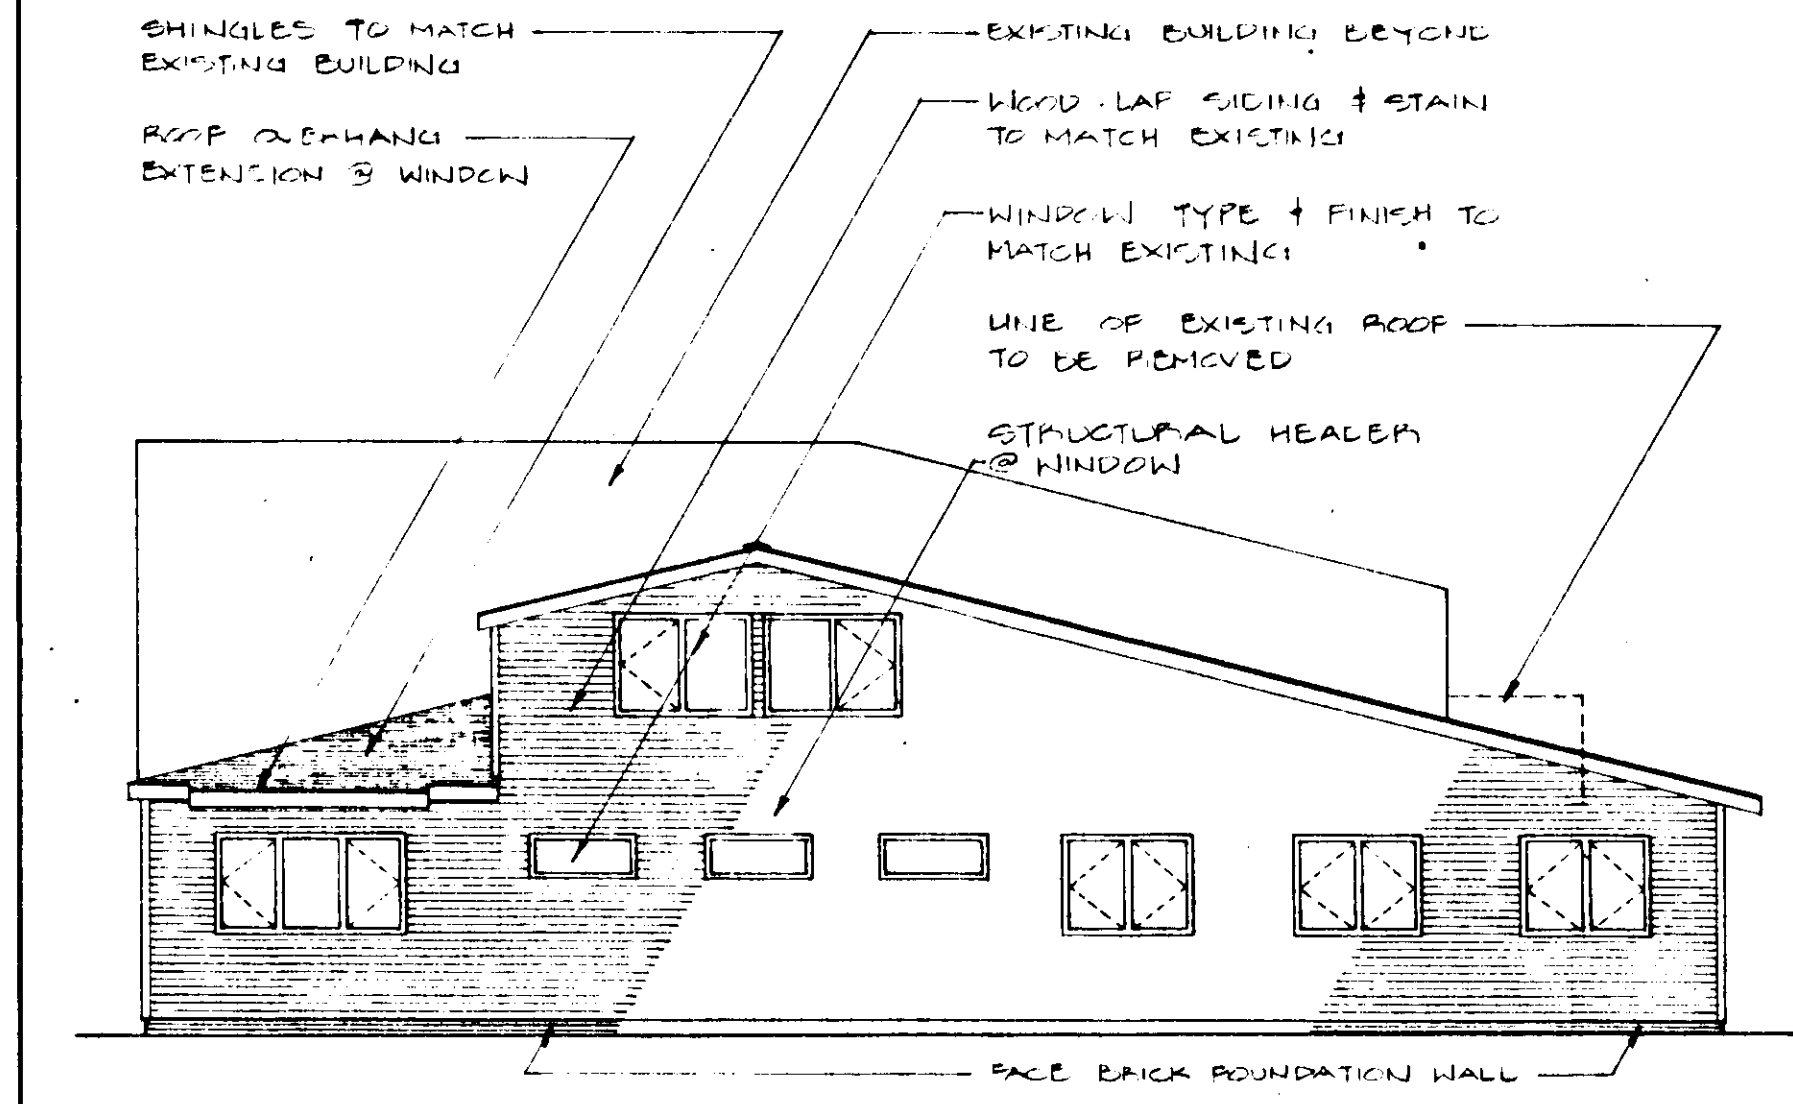

**B. EAST ELEVATION**

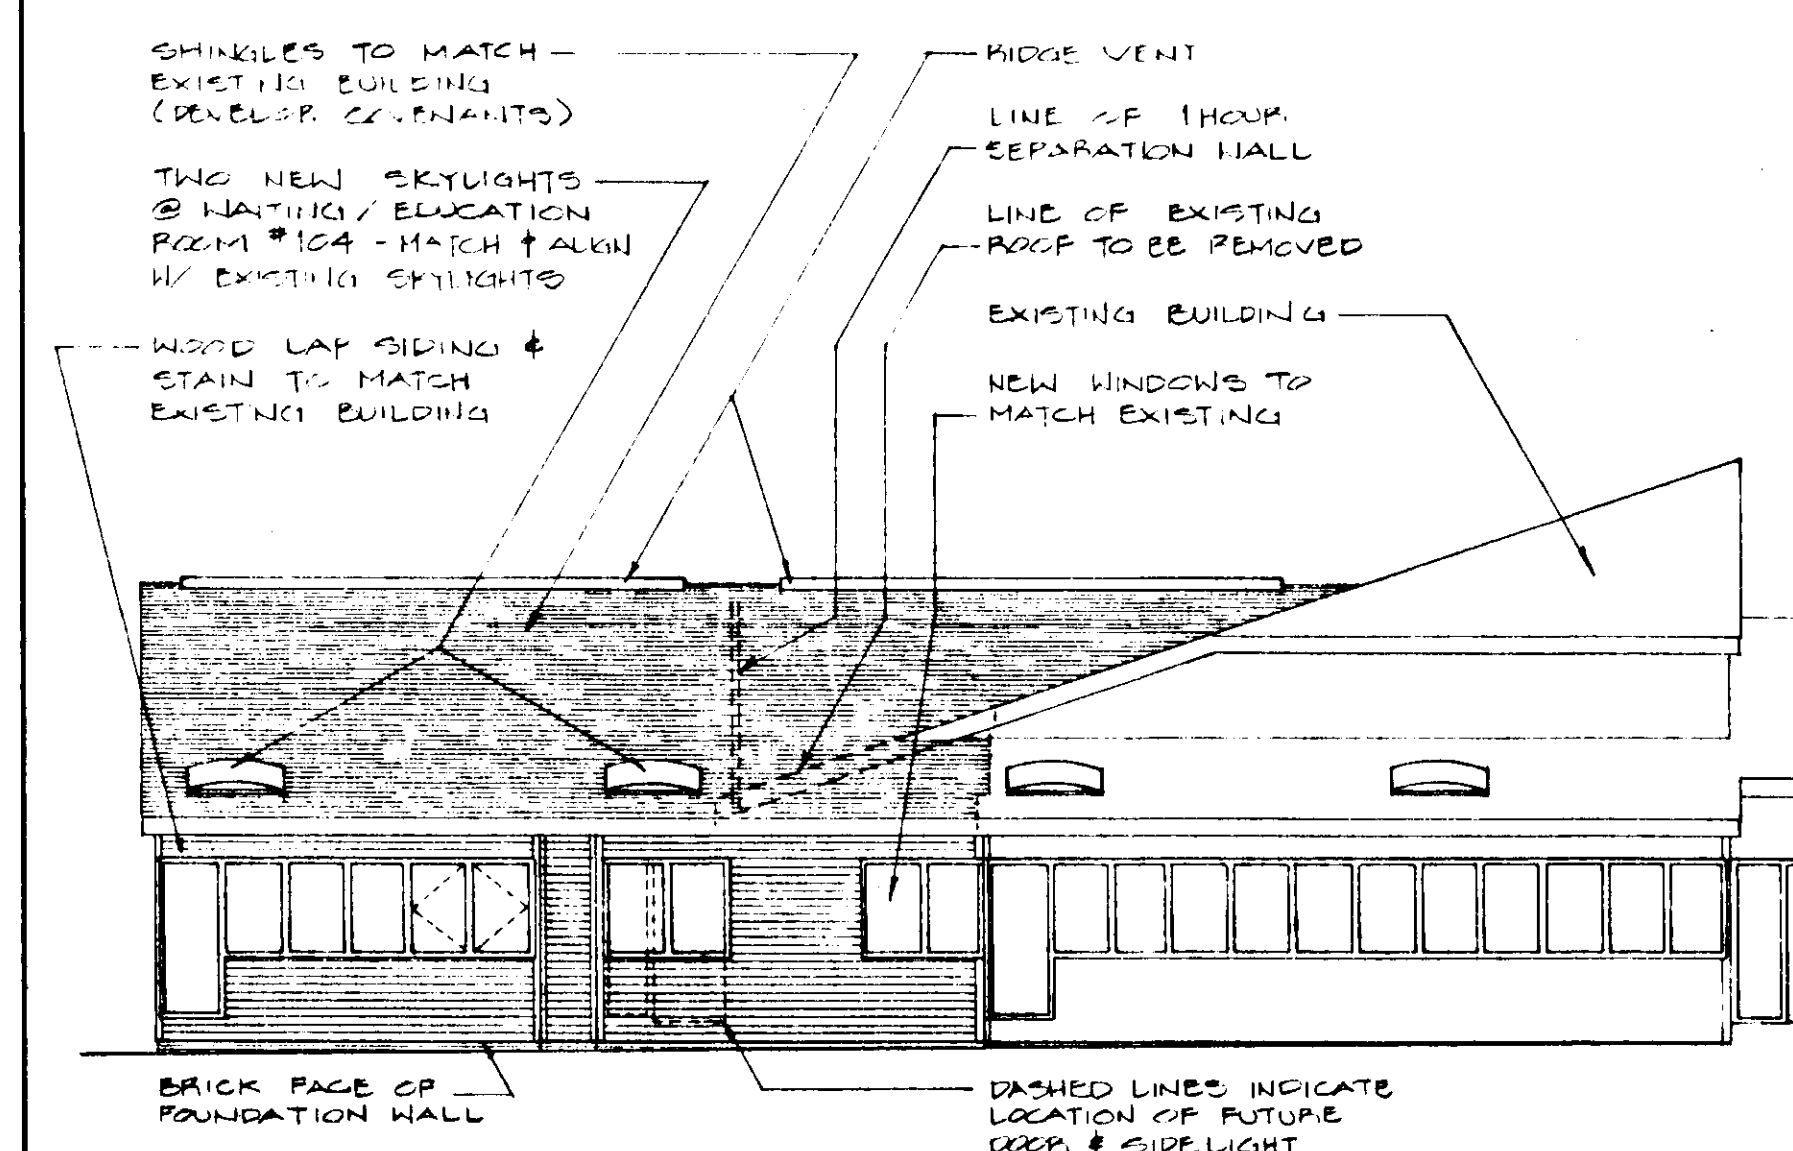

**A. NORTH ELEVATION**

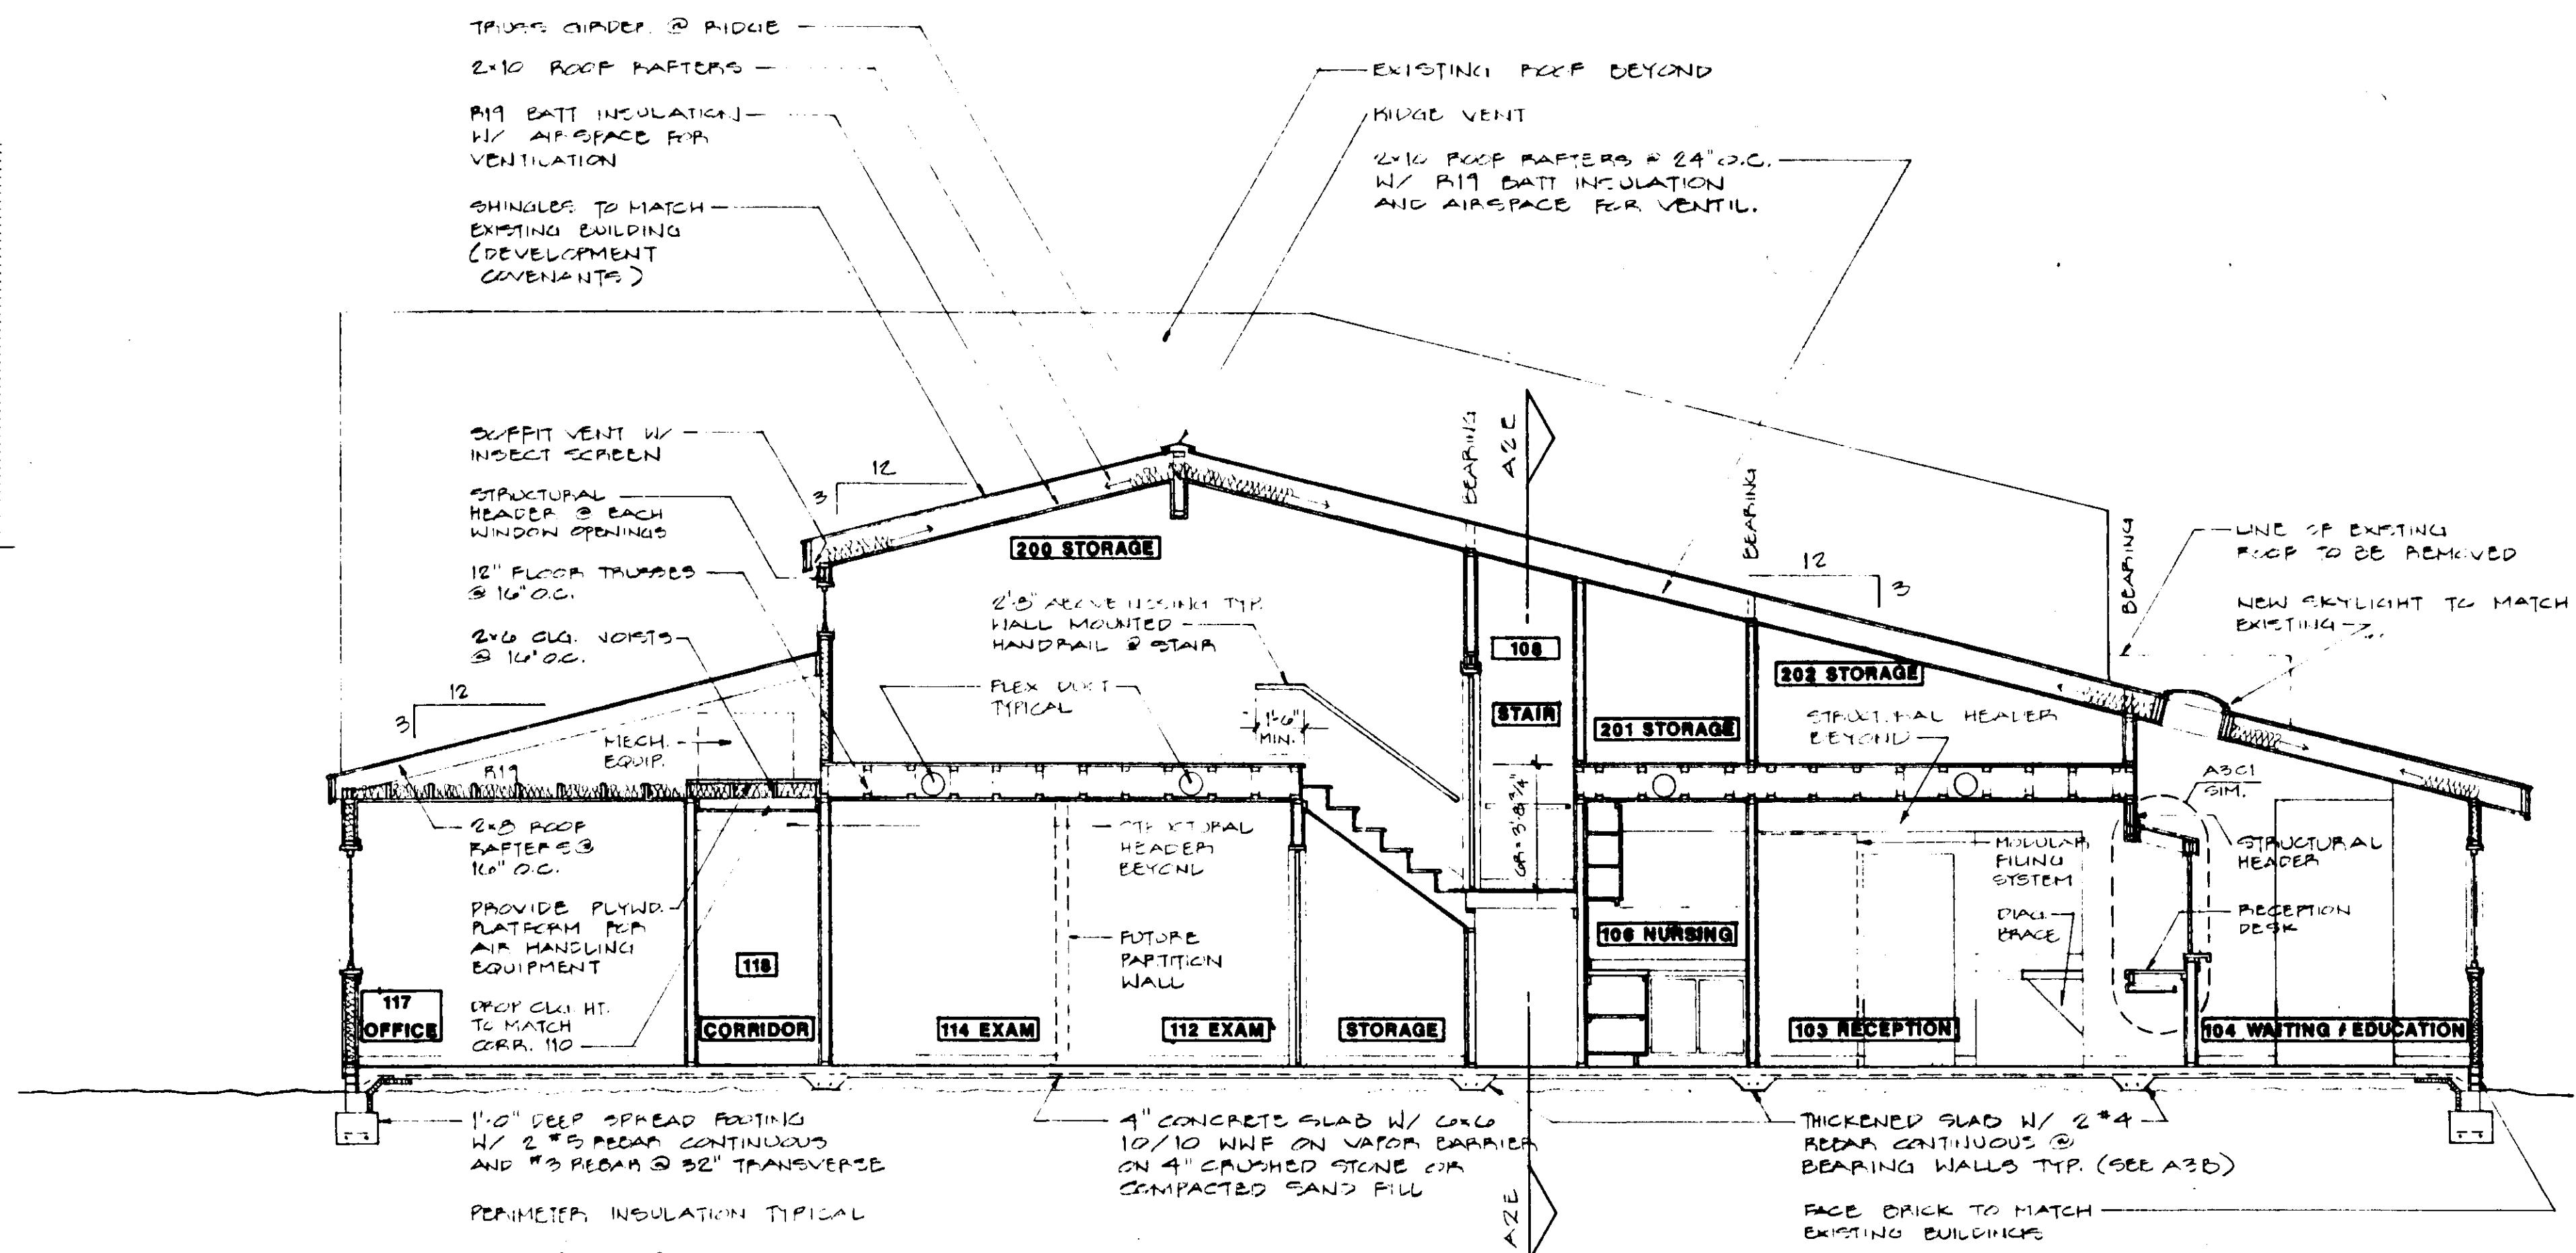

**D. BUILDING SECTION (N-S)**

**ARCHITECTURE**  
136 E. Morgan Street/Suite 100  
Raleigh, North Carolina 27601  
919-821-2775  
Copyright © 1988

ADDITION TO THE OFFICES OF:  
**DAVID B. GILBERT, M.D.**  
&  
**D. WAYNE WHITSELL, M.D.**  
1756 METROMEDICAL DRIVE  
FAYETTEVILLE,  
NORTH CAROLINA

Approved by [Signature]  
17th day of June 88

10 SE 87  
SDB  
A2  
10 SE 87  
SDB  
Cond 2-198